


T2S. R2E. WM.

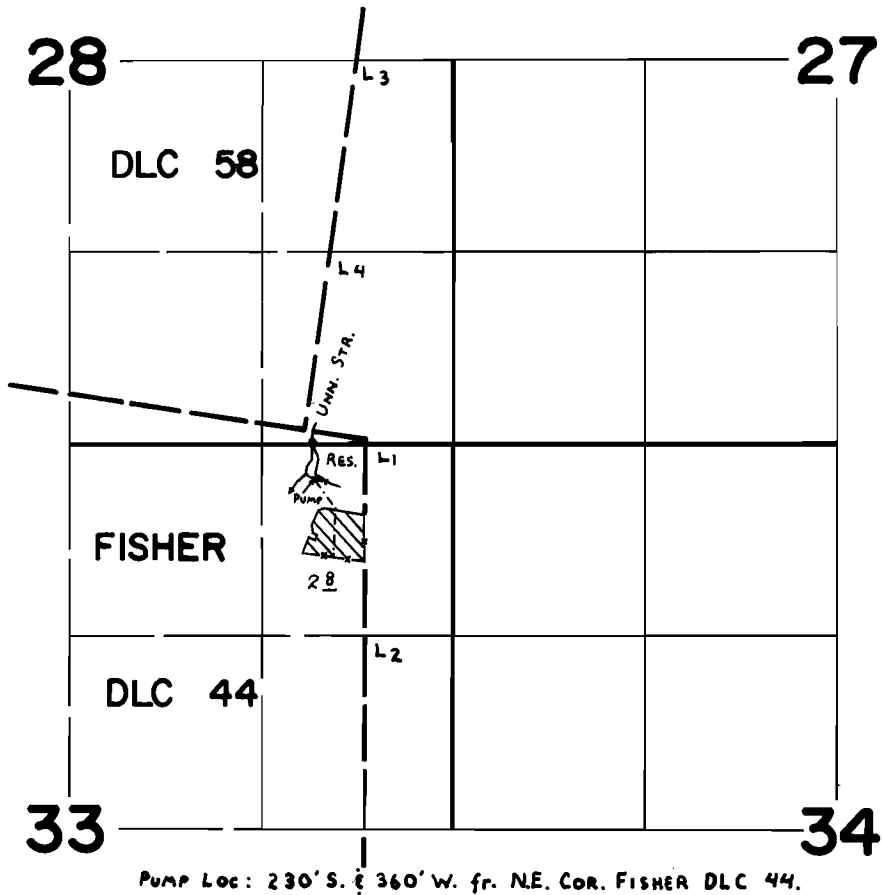

FINAL PROOF SURVEY UNDER

Application No. R-55773 55774 Permit No. R-6687 42232
IN NAME OF

Gary S. Delores Bail

Surveyed SEPT. 28 1978, by C. L. HUGHES