


T.17S. R.24E., W.M.

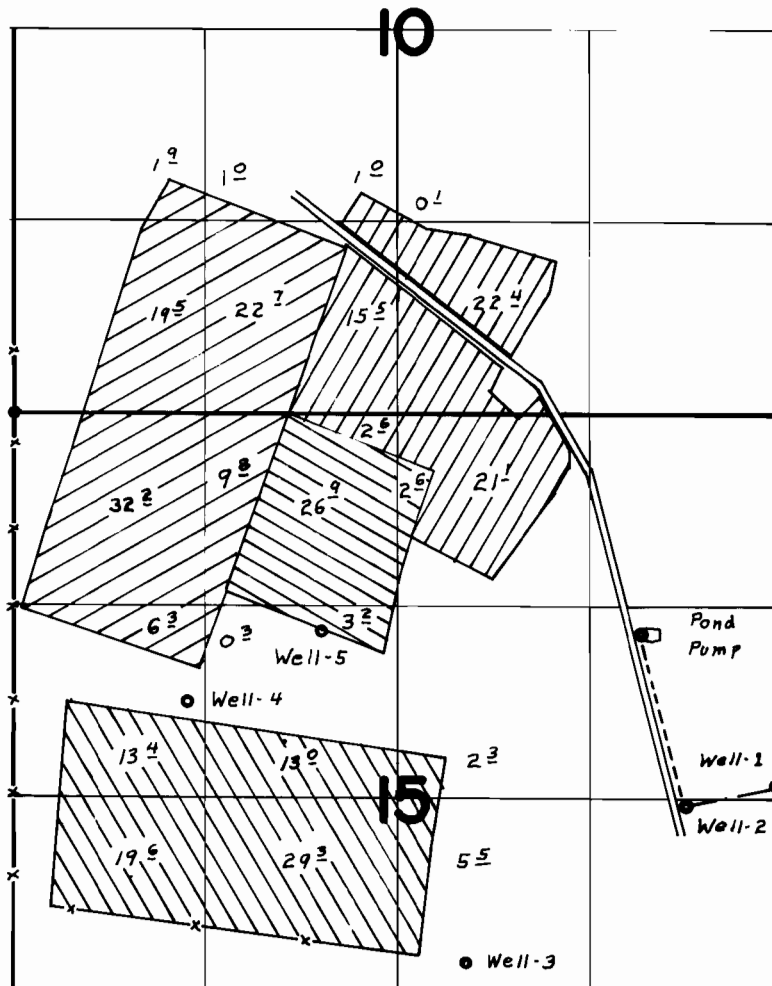

1. - 2550'S. & 5230'E.
 2. - 2680'S. & 4620'E.
 Wells Loc. 3. - 3770'S. & 3100'E. All From N.W. Cor. Sec. 15
 4. - 1980'S. & 1180'E.
 5. - 1500'S. & 2120'E.

FINAL PROOF SURVEY UNDER

	Well 1 & 2	App'l. G-5342
	Well 3	
	Well 4	
	Well 5	App'l. G-6528

G-5342 G-5286
 Application No. G-6528 Permit No. G-5806
 IN NAME OF

BEF. QUARTER CIRCLE SEVEN, INC.

Surveyed AUG. 2, 1978, by J.S. DONALDSON