


T. 29 S., R. 7 W., W.M.

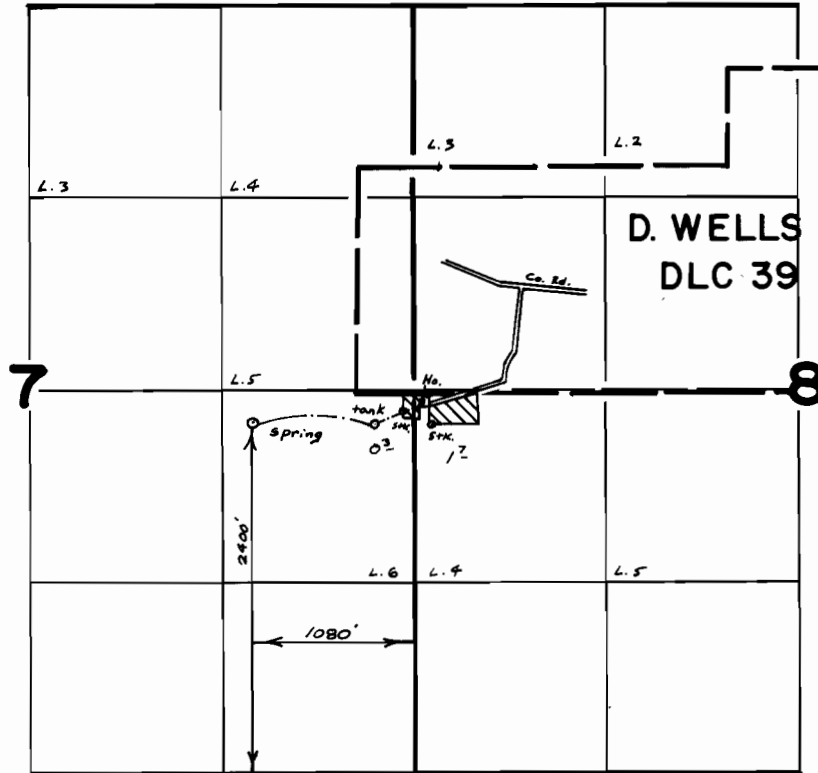

SCALE 4" = 1 mile

FINAL PROOF SURVEY UNDER

Application No. 51044.. Permit No. 38521...
IN NAME OF

.....ARTHUR.....L.....STEVENS.....

Surveyed June...4, 1979, by S..Donaldson..