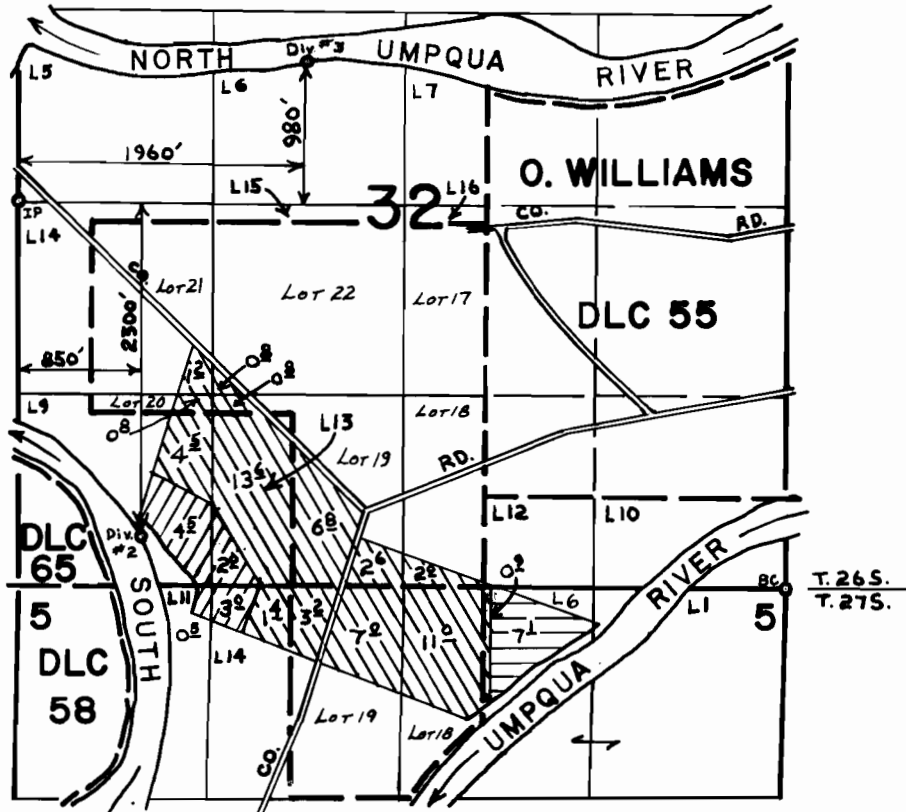

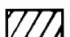


# T. 26 & 27 S., R. 6 W., W.M.



-  Div.#2
-  Div.#3 (Supplemental)
-  Over acreage

## FINAL PROOF SURVEY UNDER

Application No. 50194 Permit No. 39111.....  
 IN NAME OF  
**DON KRUSE**

Surveyed MAY 3 1978, by D.W. SPARKS.....