


T.24S., R.6W., WM

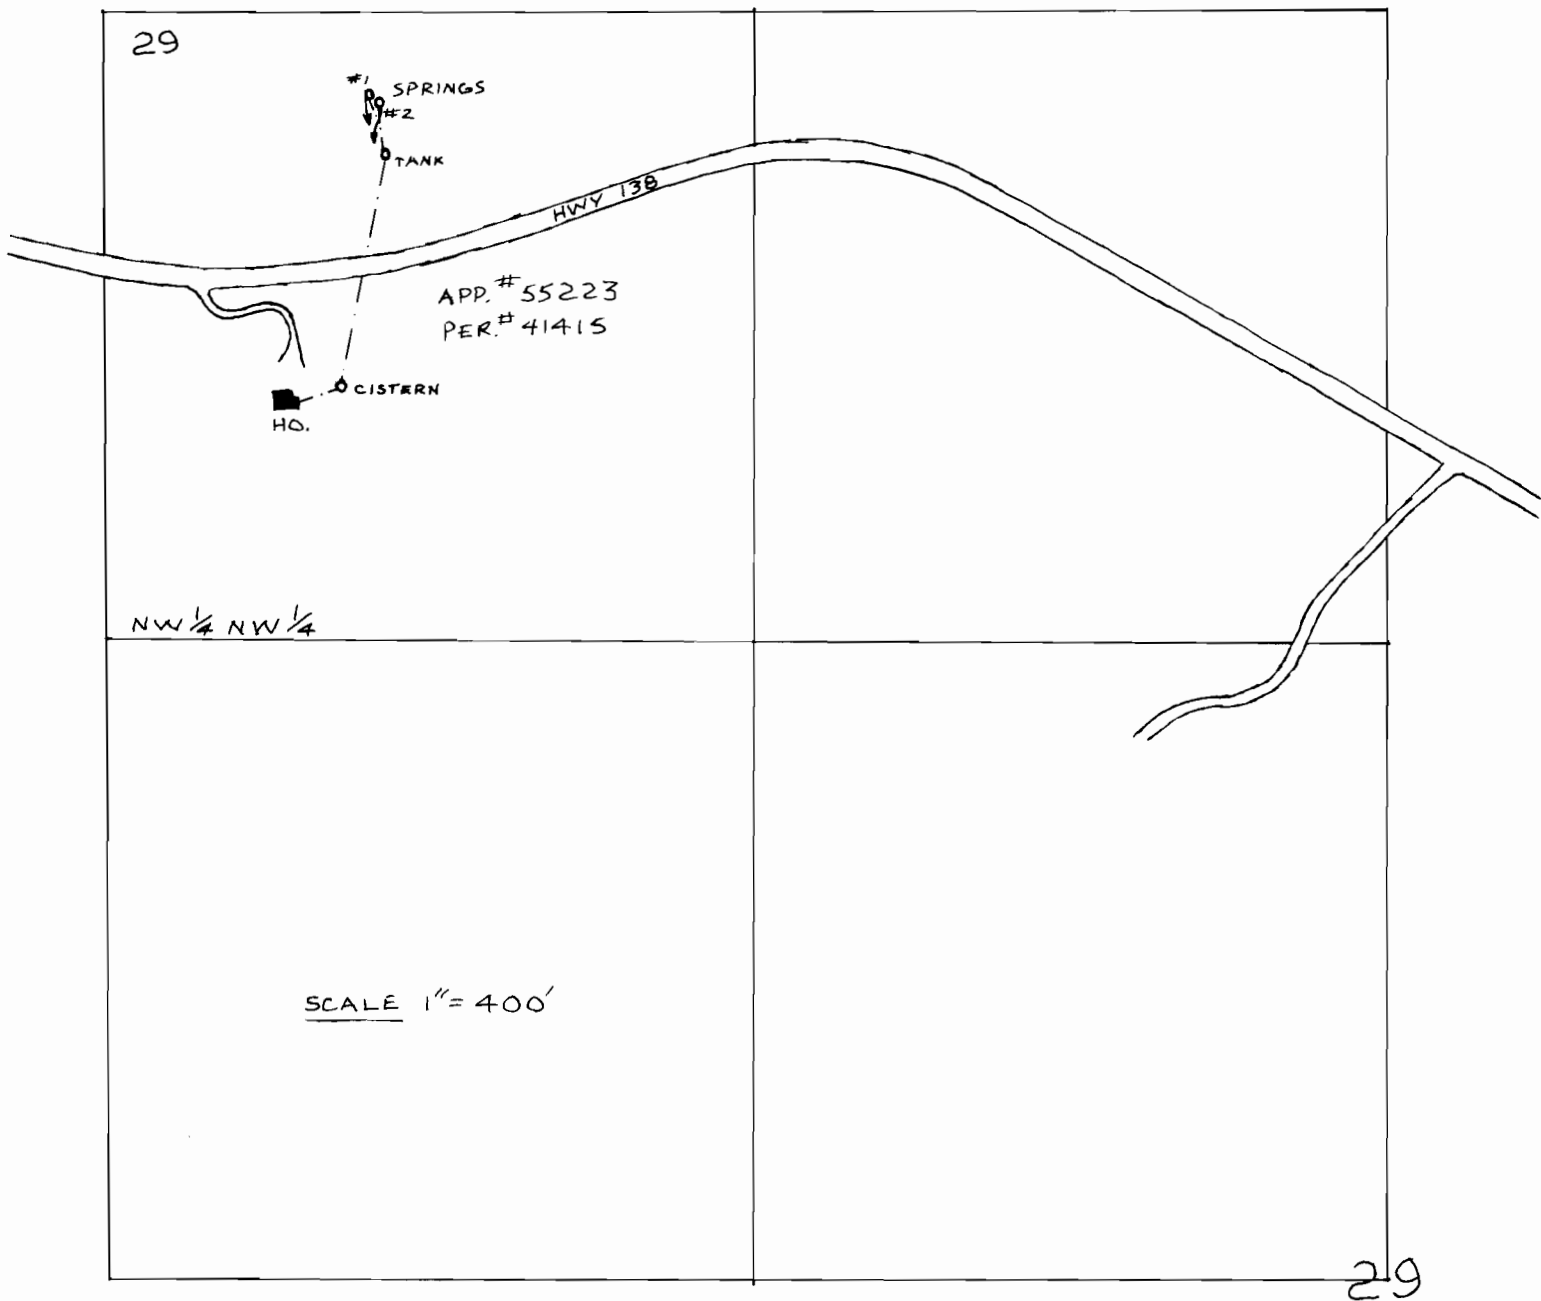

SPRING #1 - 170'S. & 550'E. } FROM THE N.W. COR. SEC. 29  
#2 - 190'S. & 575'E. }