


T.39S.,R.4W.,W.M.

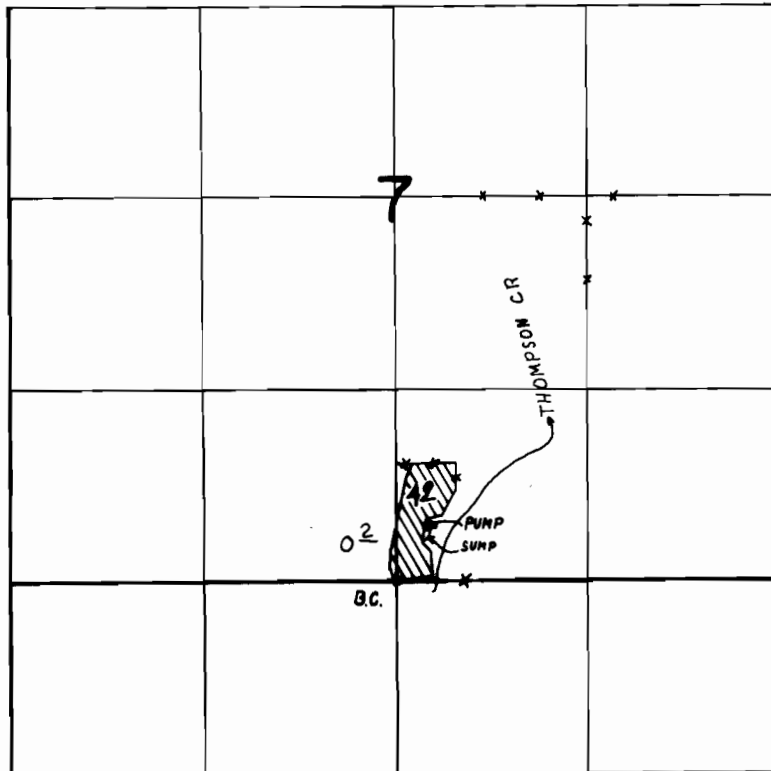

SUMP: 350' N & 225' E FROM THE S 1/4 COR SEC. 7

**FINAL PROOF SURVEY**  
UNDER

Application No. G-5895 Permit No. G-5614  
IN NAME OF

ARLENE GILLESPIE

Surveyed APR 30 1976, by C.R. KING