


G-7044  
51198

T. 2N. R. 28E.

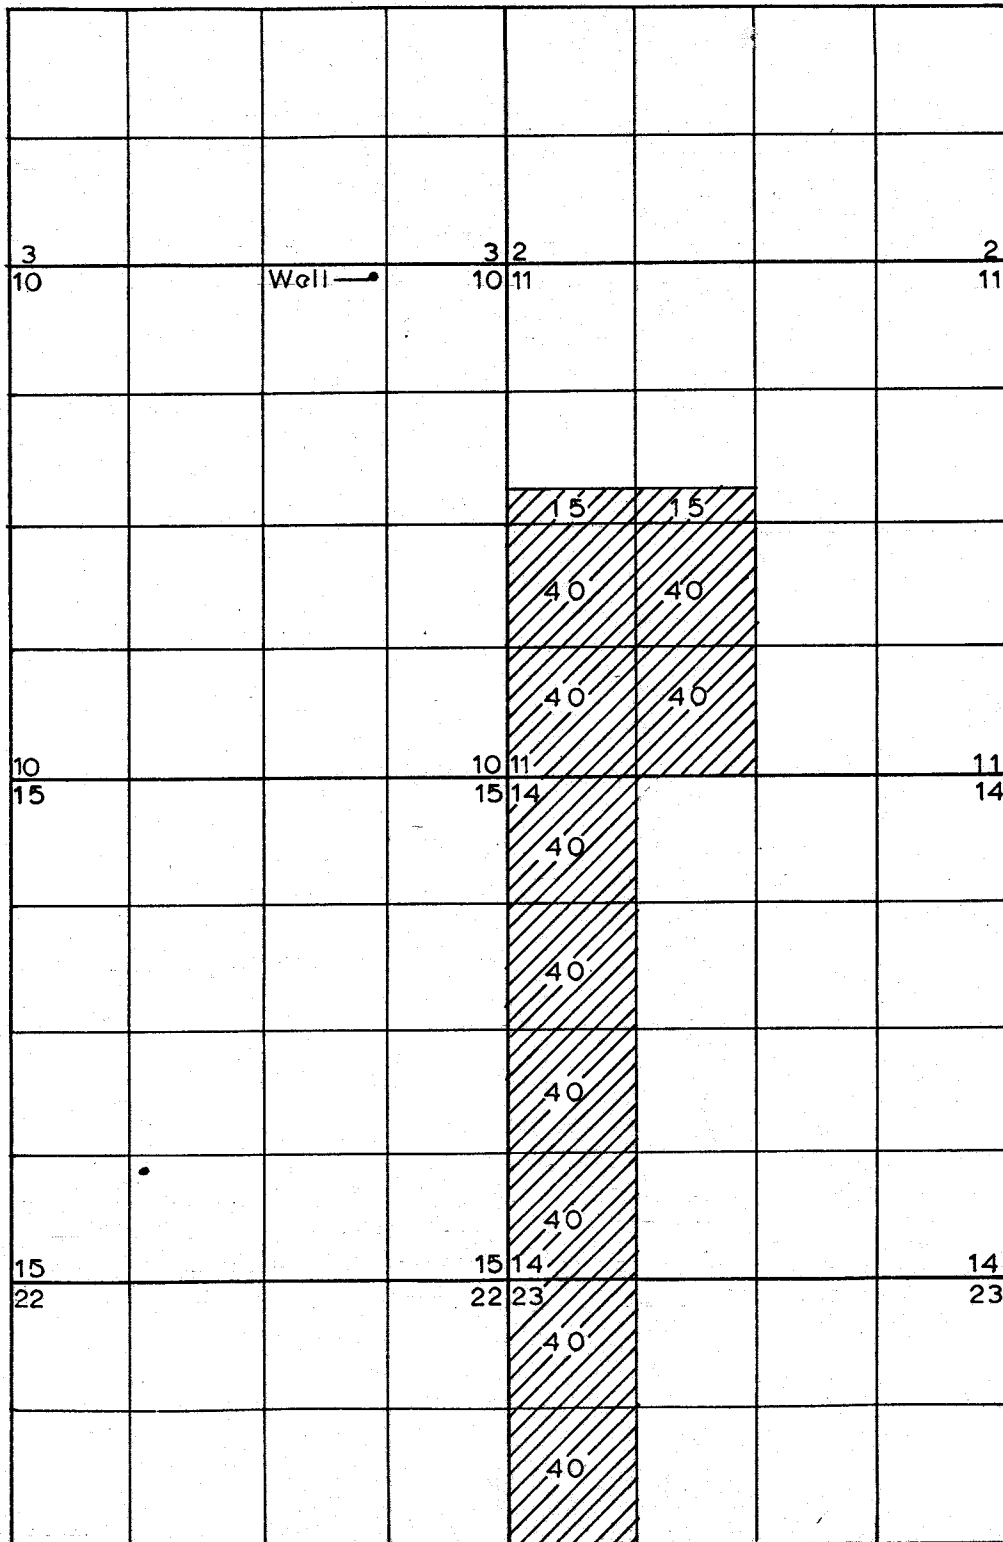

Application No. G-7543  
Permit No. G-7014

**RECEIVED**

OCT 15 1976

WATER RESOURCES DEPT.  
SALEM, OREGON

WELL LOCATION—100' S. 1200' E. FROM THE N1/4CR.