


7/19/82

Del  
Green area canceled  
fcs

G-1080  
S1199 R R

# T.40 S.R.11 & 12 E.W.M.

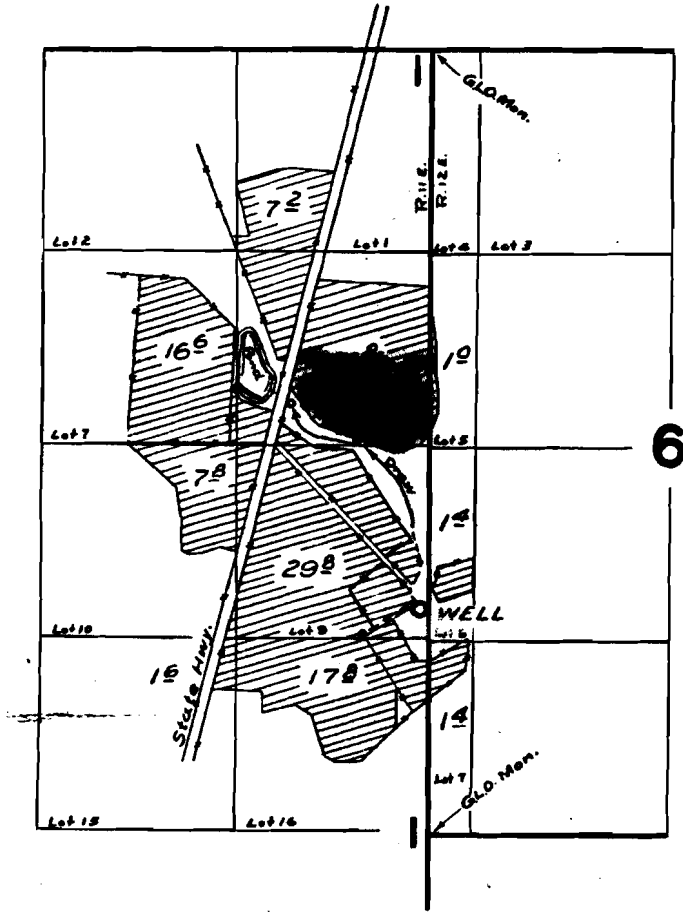

## FINAL PROOF SURVEY

UNDER

Application No. G-1252 Permit No. G-1080

IN NAME OF

**FRANCIS OSCAR & MARGARET WILLNETTA FREUER**

Surveyed 19 Oct. 1959 by M. G. Bish

1959F