


T.39 & 40S. R.20E. W.M.

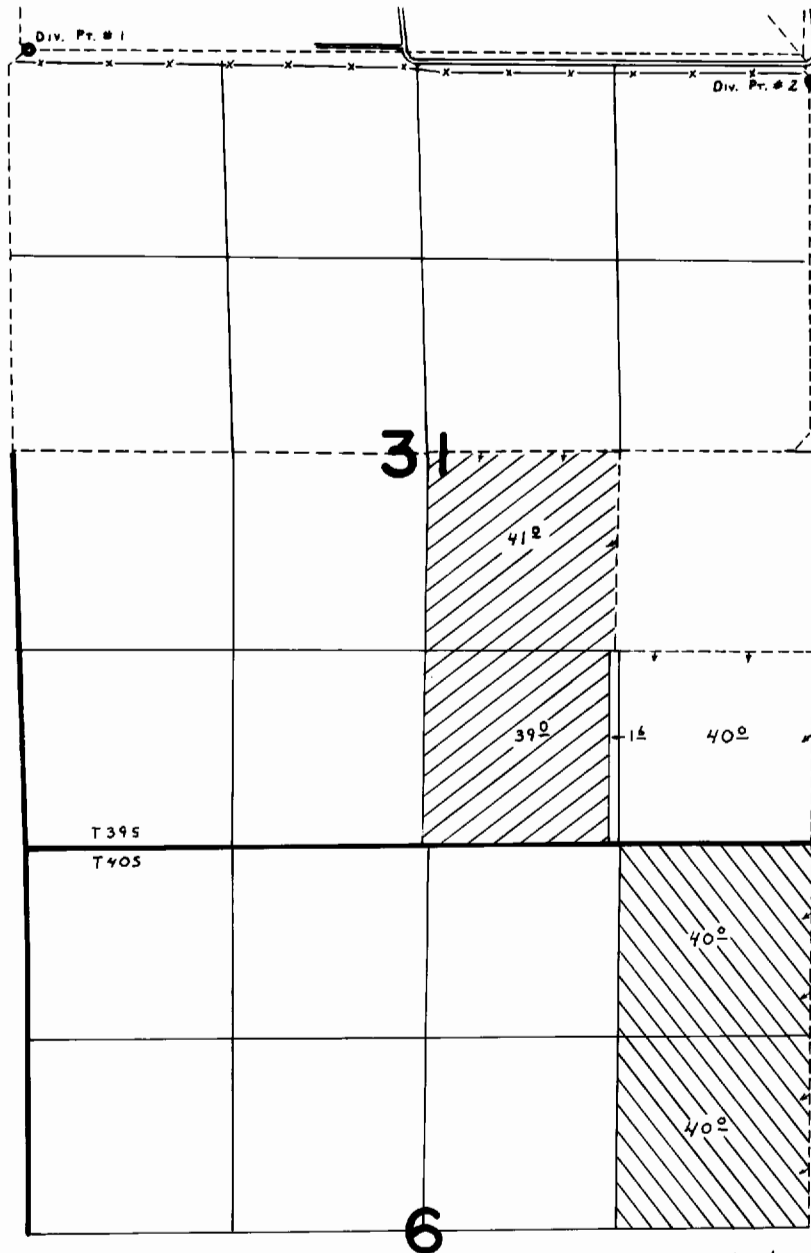

 - PRIMARY IRR. (APP. 47896)

 - SUPP. IRR. (APP. 47895)

Div. Pts. Loc: #1 - 90' N. $\frac{1}{2}$ 150' E. fr. N.W. Cor. } SEC. 31
#2 - 70' S. $\frac{1}{2}$ 30' W. fr. N.E. Cor. }

FINAL PROOF SURVEY UNDER

Application No. **47895** **35889**
~~47896~~ Permit No. ~~35890~~...
IN NAME OF

..... **L. W. GARRETT**

Surveyed June 9, 1980, by C. L. HUGHES.