


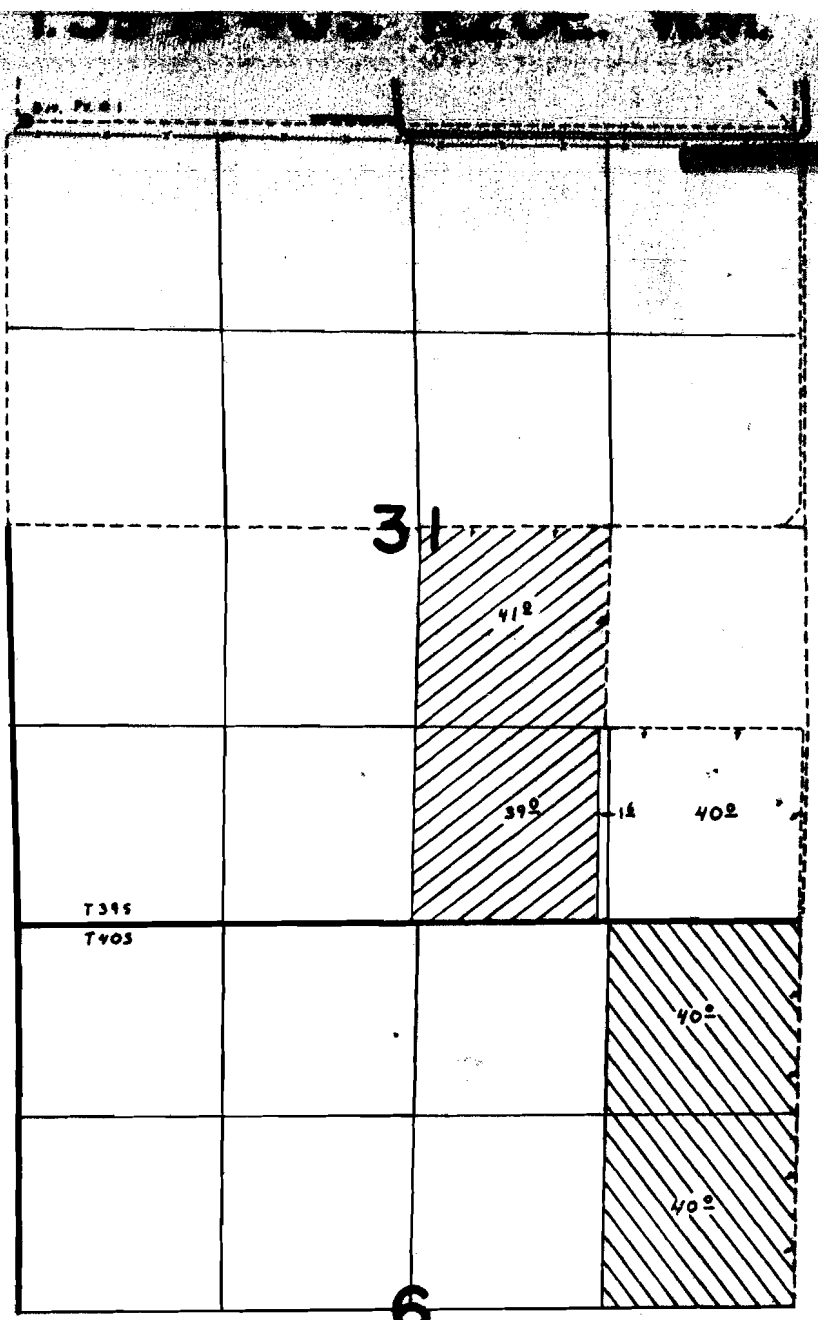

- PRIMARY IRR. (APP. 47896)  
 - SUPP. IRR. (APP. 47895)

Div. Pts. Loc: #1- 90° N.  $\frac{1}{2}$  150' E. fr. N.W. Cor. } Sec. 31  
 #2- 70° S.  $\frac{1}{2}$  30' W. fr. N.E. Cor. }

# FINAL PROOF SURVEY UNDER

Application No. **47895** Permit No. **35889** <sup>ct 51203</sup>  
**47896** **35890** <sup>ct 51204</sup>  
 IN NAME OF

.....**L. W. GARRETT**.....

Surveyed June 9, 1980, by C. L. HUGHES.