


T.18S.R.2W.W.M.

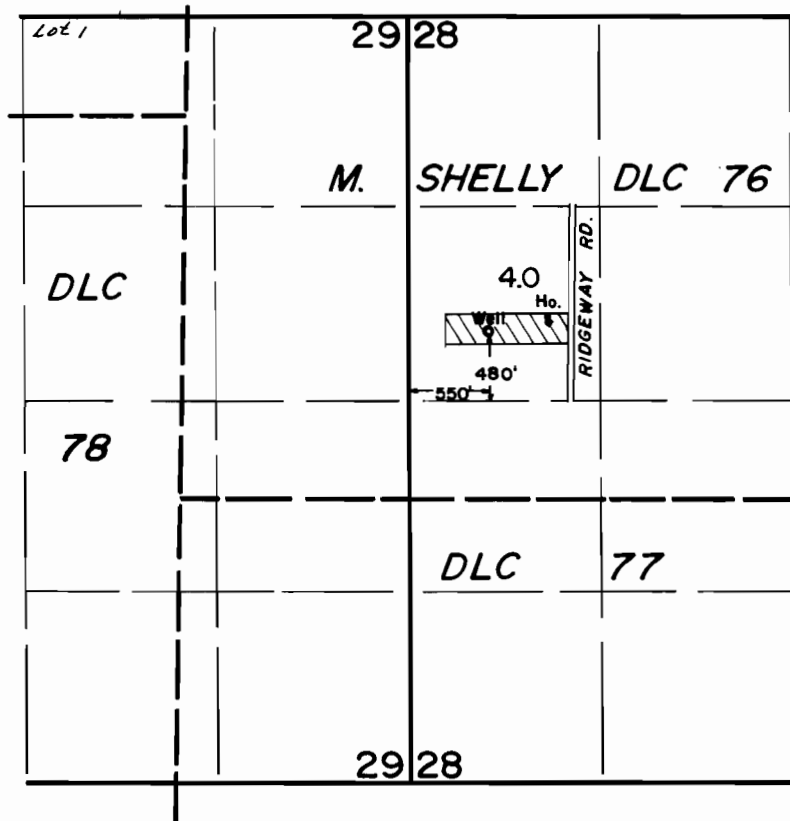

FINAL PROOF SURVEY
UNDER

Application No. G-7978. Permit No. G-7671.....
IN NAME OF

.....*Eugene J. Helen Seales*.....

Surveyed June 27, 1979, by SC. BROWN.....