Final Proof Survey

UNDER

Application No. 4100 Permit No. 3640

IN NAME OF

McKenzie Irrigation Association

Surveyed May 15, 16, 17, 18, 1961
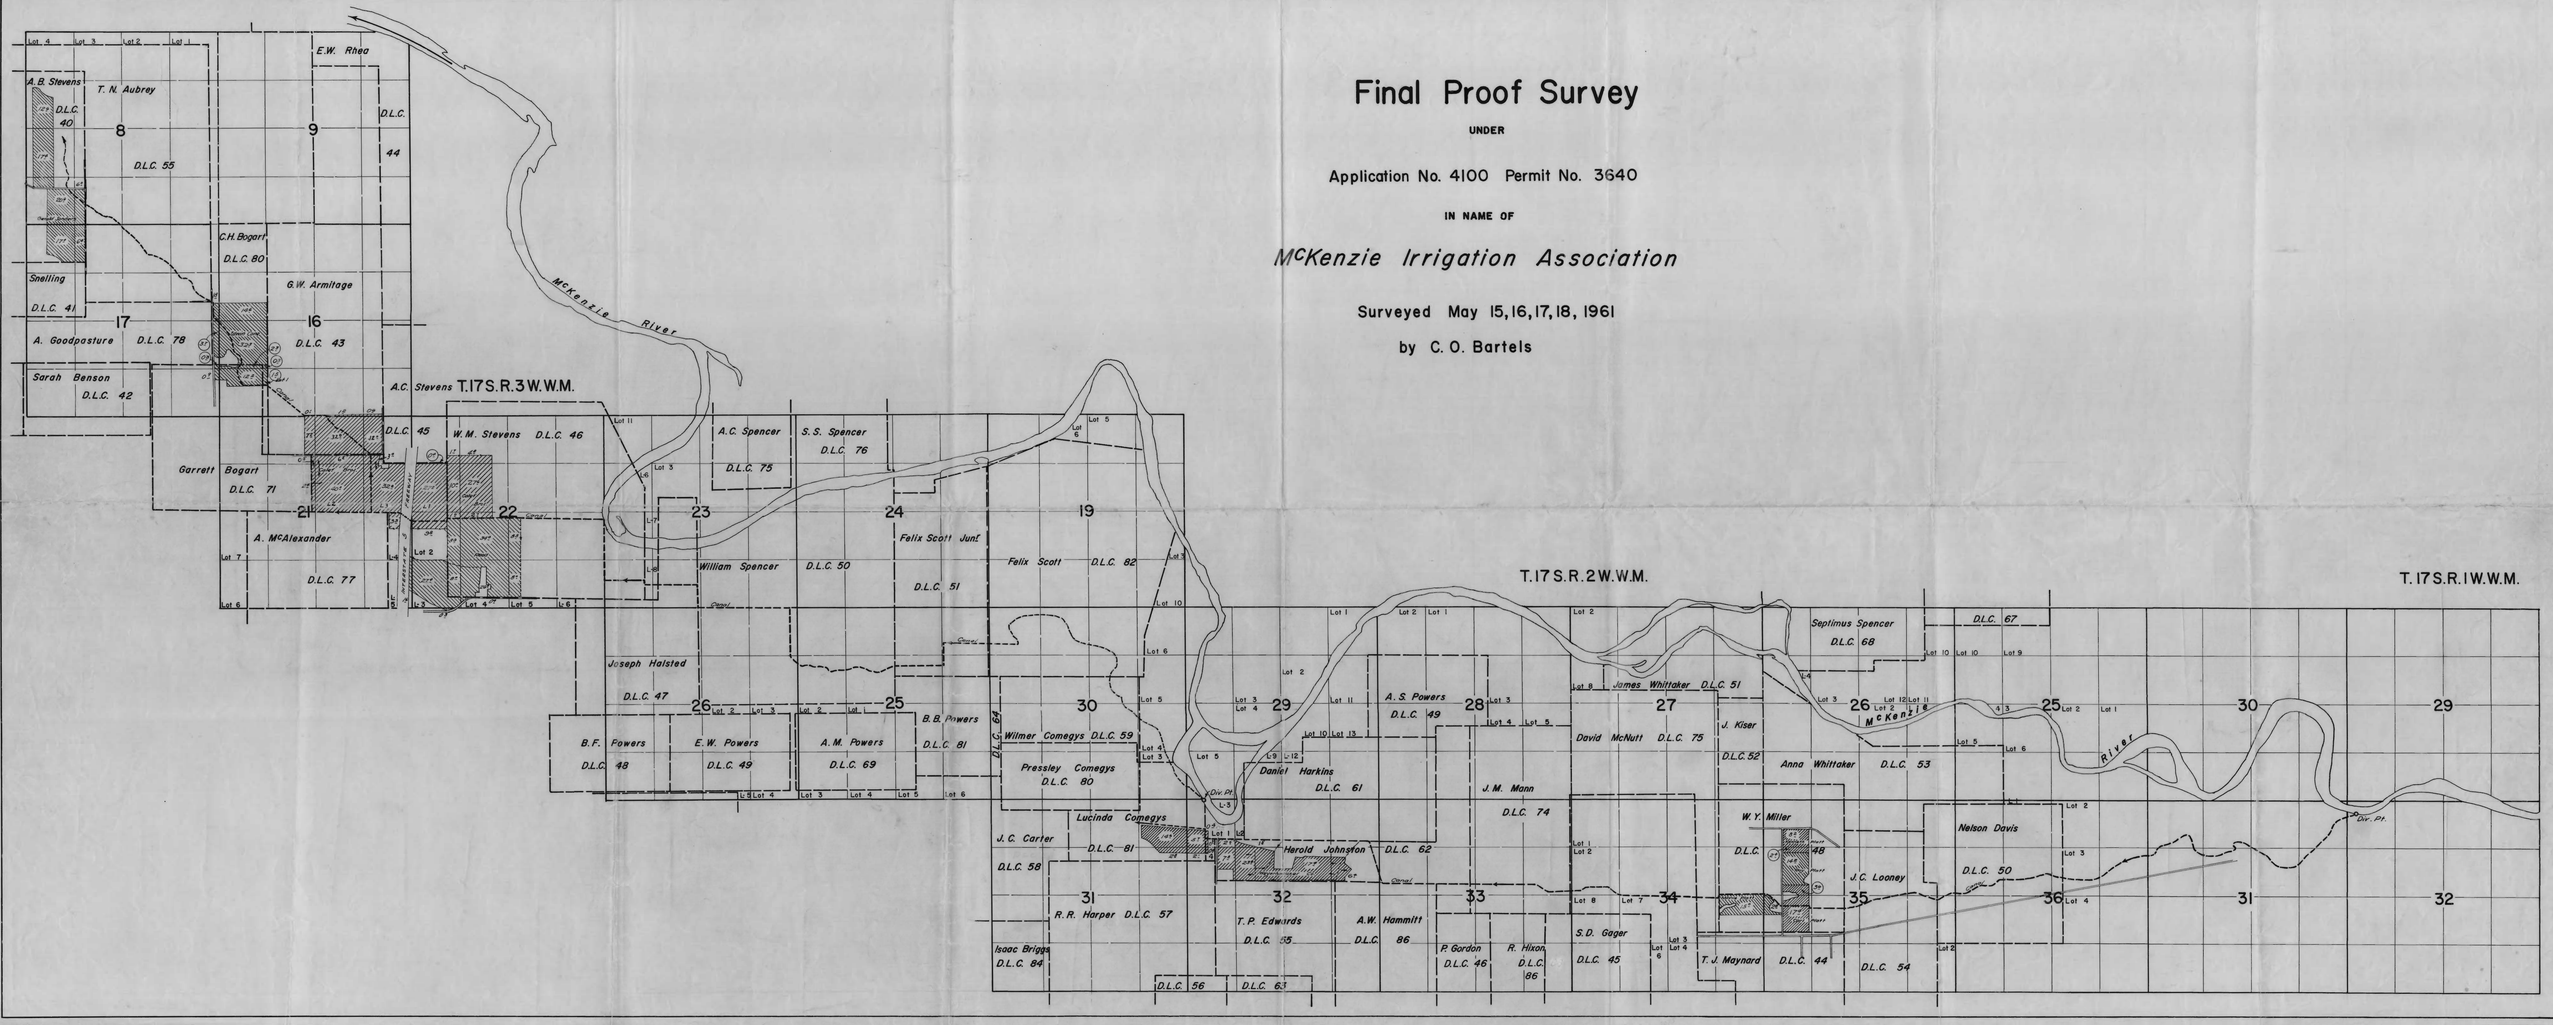
by C. O. Bartels