


T19S. R11W. WM.

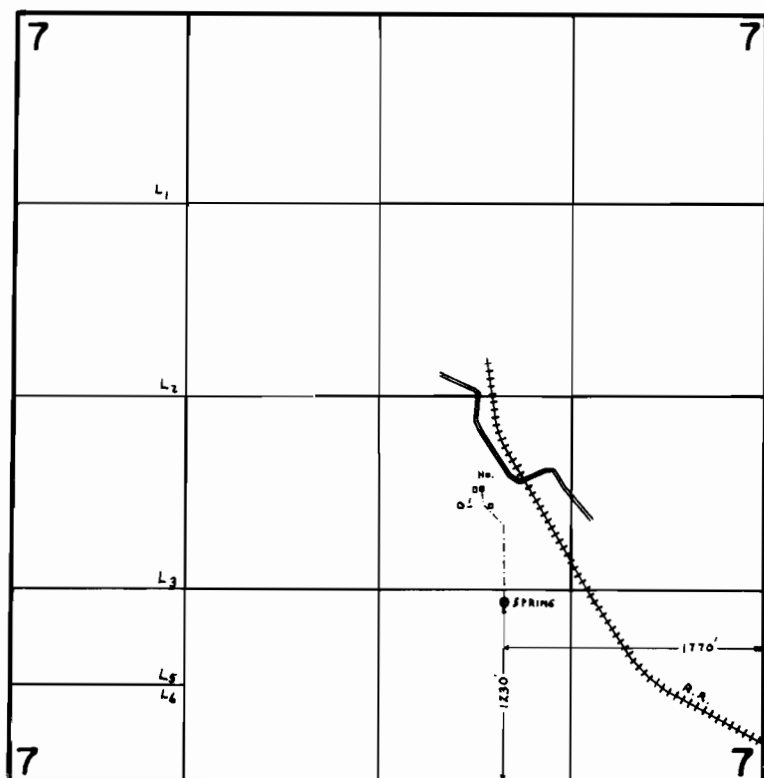

FINAL PROOF SURVEY
UNDER

Application No. 45199 Permit No. 33407
IN NAME OF

BLANCHE CARICO

Surveyed JULY 26 1978, by C. L. HUGHES