


G-5763
51219

T. 5N. R. 29E. W.M.

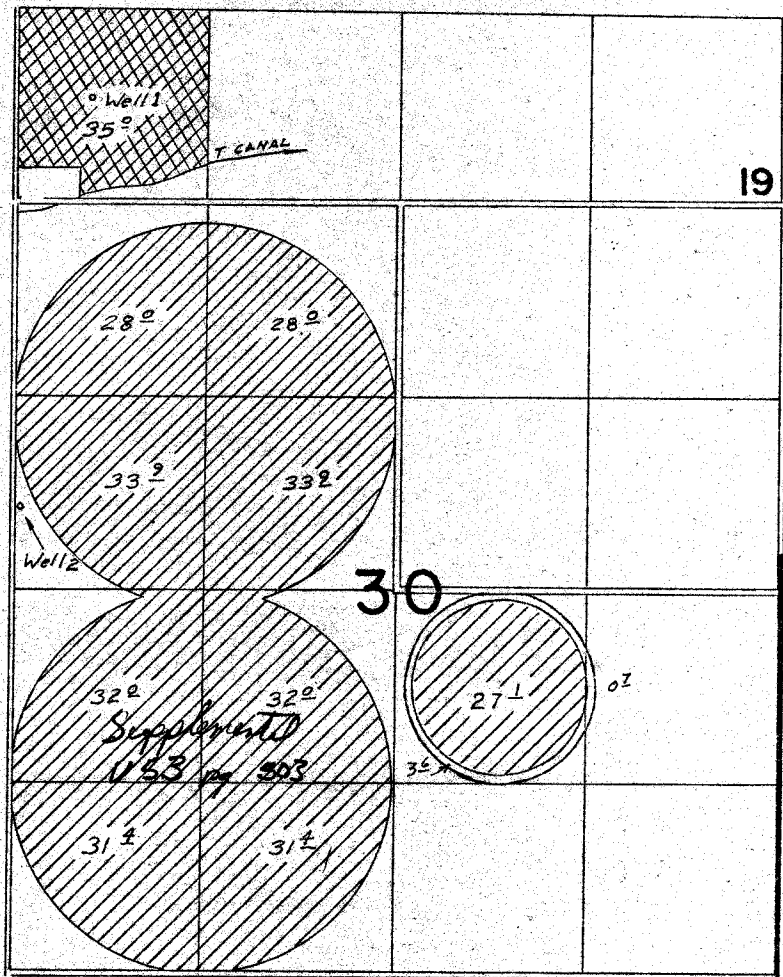

Well 2 Loc.: 2080 ft. S. & 40 ft. E. from NW Cor. Sec. 30
 Well 1 Loc.: 700 ft. N. & 510 ft. E. from SW Cor. Sec. 19

 PRIMARY
  SUPP'L

FINAL PROOF SURVEY UNDER

Application No. G-6076 Permit No. G-5763
 IN NAME OF

W. Bryan Wolfe et al

Surveyed 10-26 1978, by R. BARWIN
7-24 76 L. H. NUNN