


T. 2S. R. 37E. W.M.

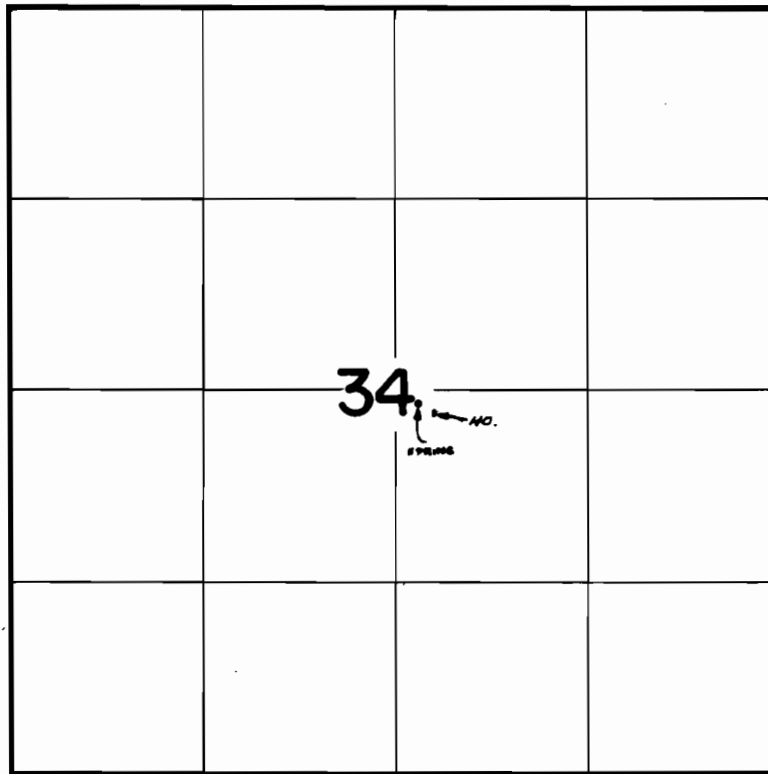

SPRING LOCATED 100'S & 2500'W FROM E 1/4 COR. OF SEC 34

FINAL PROOF SURVEY
UNDER

Application No. 48399 Permit No. 36344
IN NAME OF

ADRIA TESKE

Surveyed 10-11-1977, by R. BARWIN