


T.26S. R.5W. W.M.

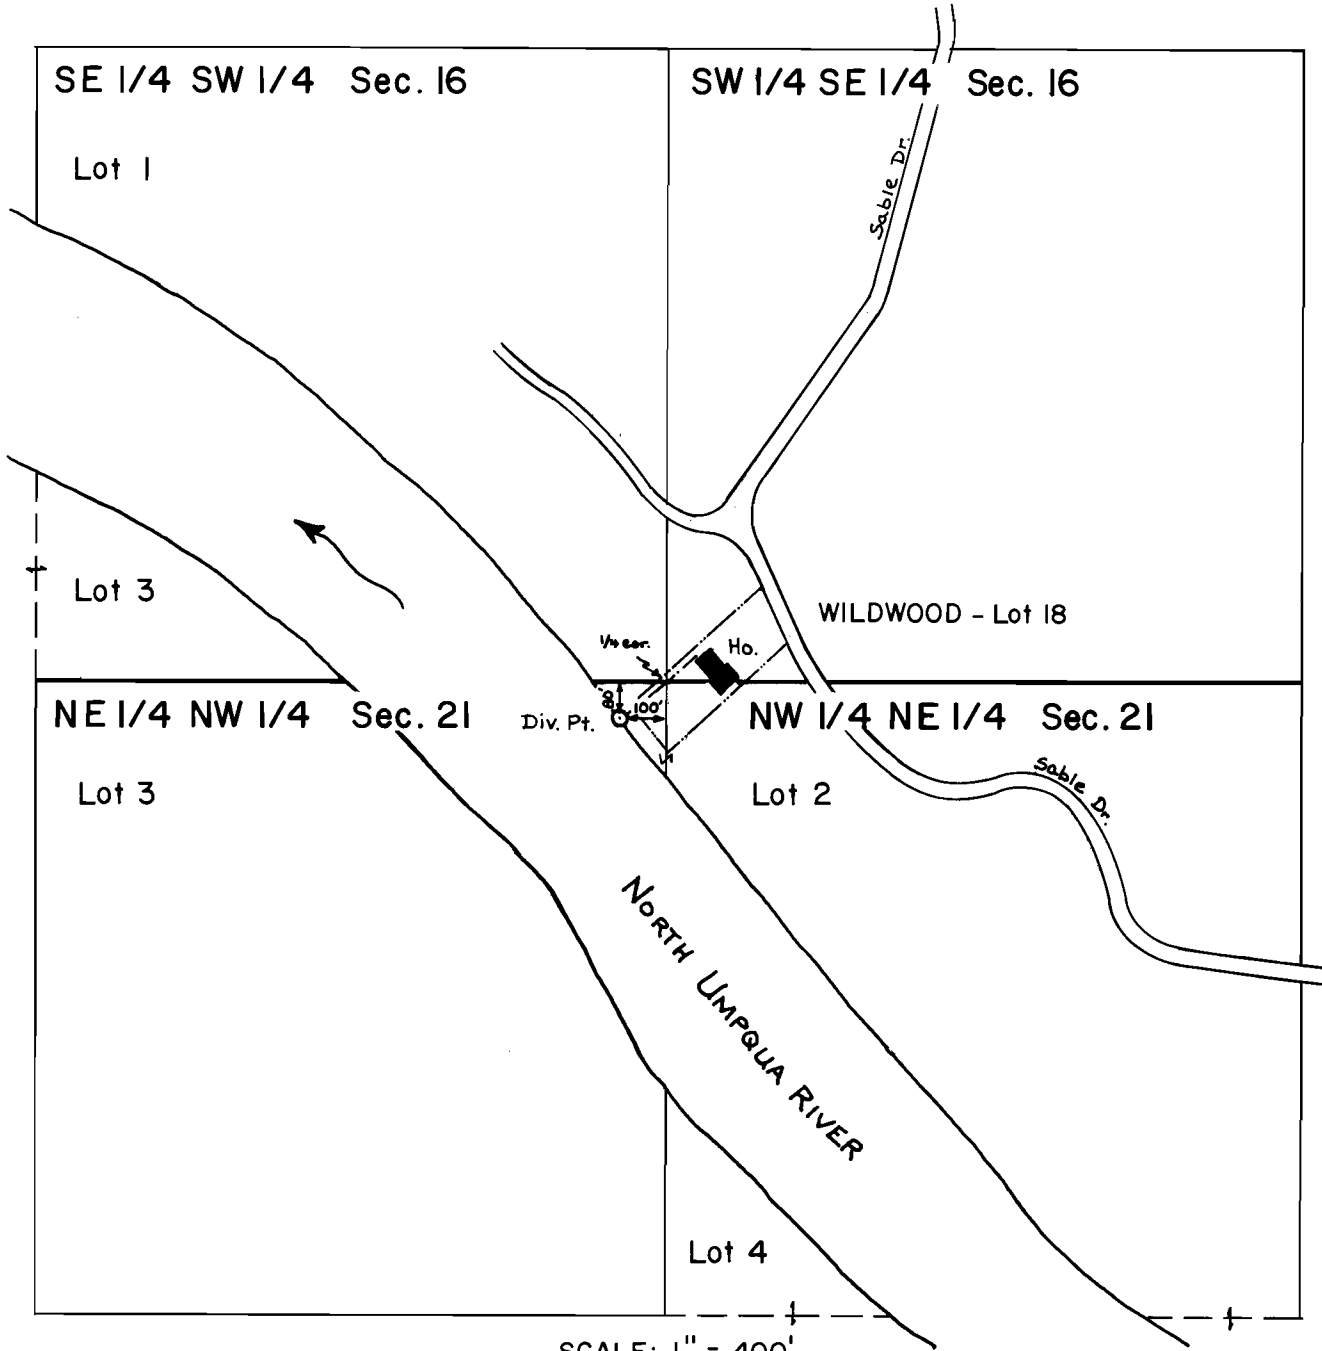

FINAL PROOF SURVEY
UNDER

Application No. 57443 Permit No. 43281.....
IN NAME OF

.....*Alexander W. Koch*.....

Surveyed April 30, 1979., by S. Donaldson....