


T.26S. R.5W. W.M.

Sec. 21

NW 1/4 NE 1/4

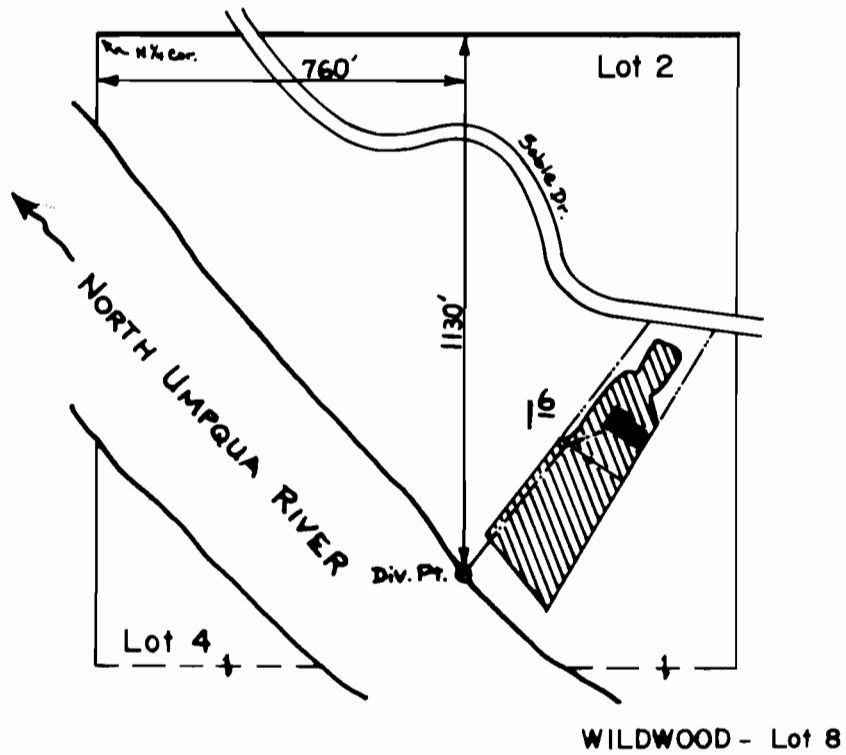

SCALE: 1" = 400'

**FINAL PROOF SURVEY**

UNDER

Application No. 58114 Permit No. 43744...  
IN NAME OF

.....Abel Family Trust.....

Surveyed March 18, 1980., by S. Donaldson.....