


T12S. R6W. WM.

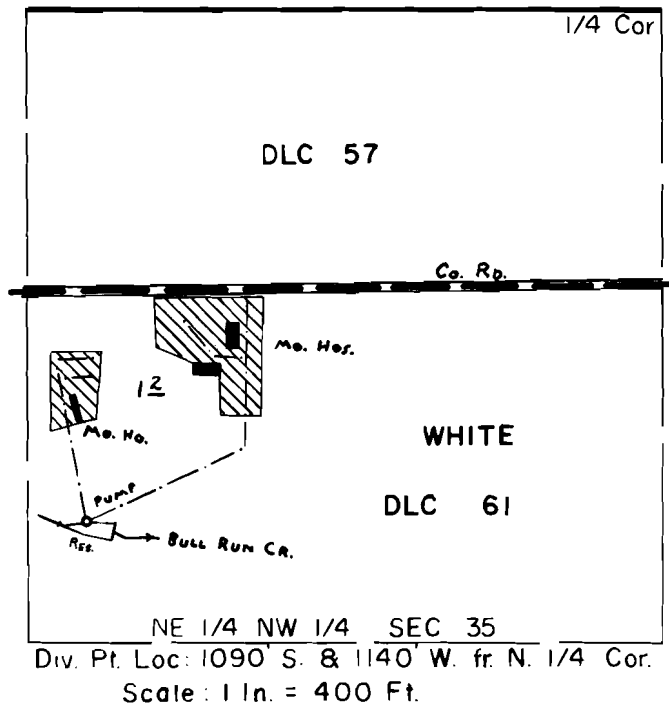

FINAL PROOF SURVEY UNDER

Application No. 53571 Permit No. 40085
IN NAME OF

ARTHUR L. ROWLAND

Surveyed Sept. 5, 1979, by C. L. HUGHES