


T. 5 S., R. 3 E., W.M.

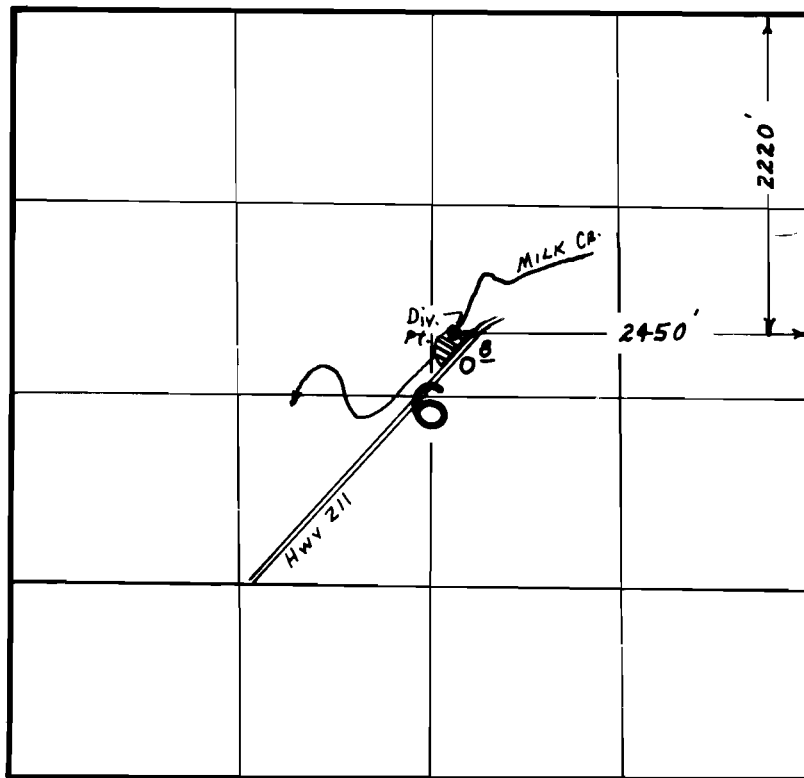

FINAL PROOF SURVEY
UNDER

Application No. 55335 Permit No. 41491
IN NAME OF

Betty C. Aurdal

Surveyed MAY 3 1978, by J.S. DONALDSON