


T5S. R1E. WM.

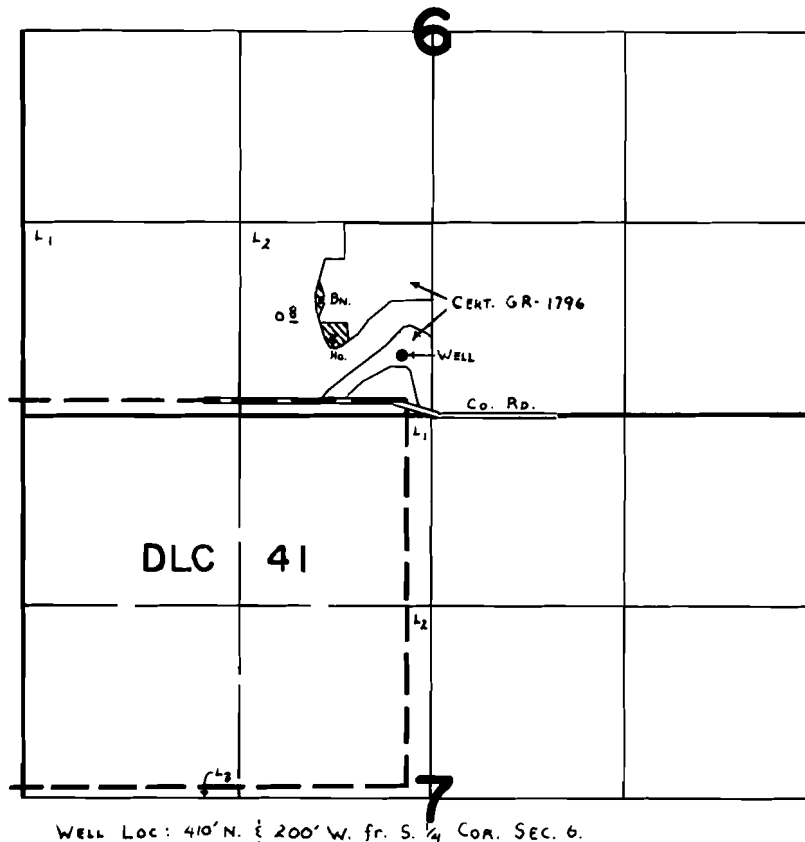

FINAL PROOF SURVEY UNDER

Application No. G-5336 Permit No. G-5480
IN NAME OF

Richard S. & Lorell Hock

Surveyed JULY 31 1978, by C. L. HUGHES