


T.5S., R.1W., W.M.

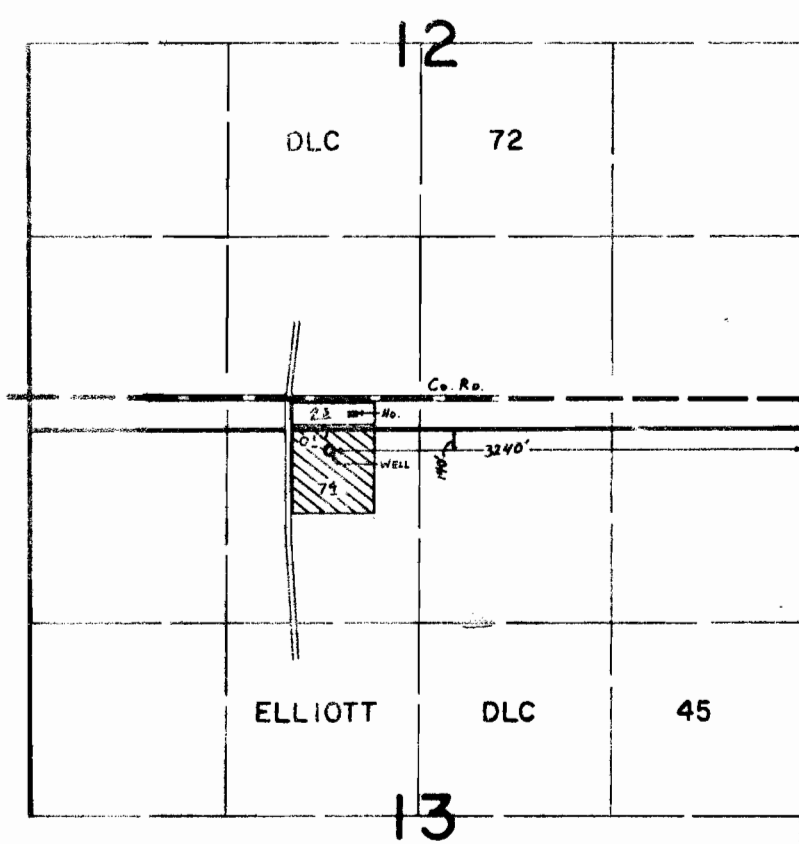

FINAL PROOF SURVEY
UNDER

Application No. G-6156. Permit No. G-5842.
IN NAME OF

DEMETRIO BURKOFF

Surveyed Oct. 11, 1979, by C. L. HUGHES