


T. 5 S., R. 1 E., W. M.

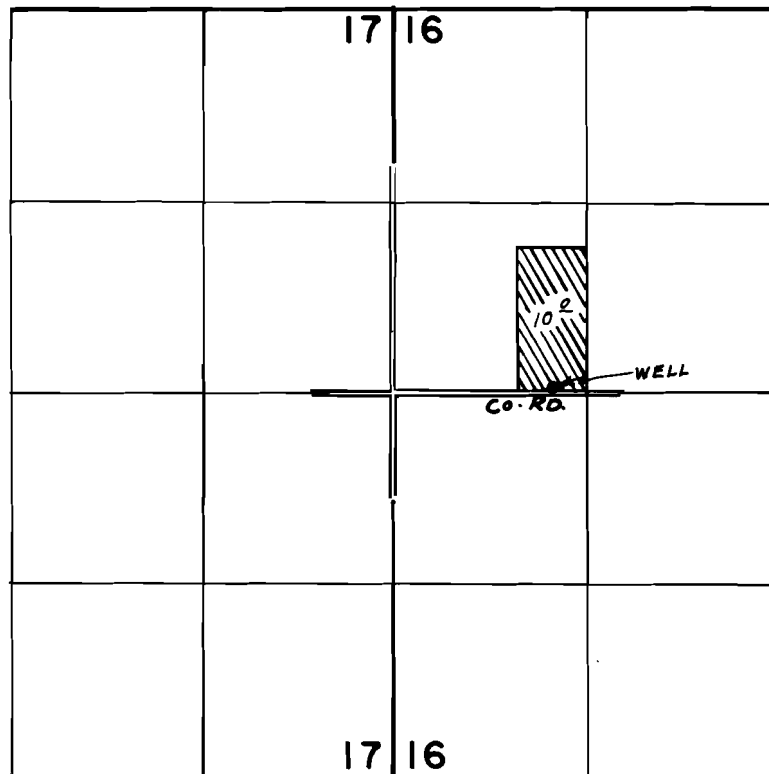

Well Located 40' N. & 1100' E. From W. 1/4 Cor. Sec. 16

FINAL PROOF SURVEY
UNDER

Application No. G-6794 Permit No. G-6302
IN NAME OF

MARCIANO MENDEZ

Surveyed May 1, 1978, by J. S. DONALDSON