


T.4S.,R.1E.,W.M.

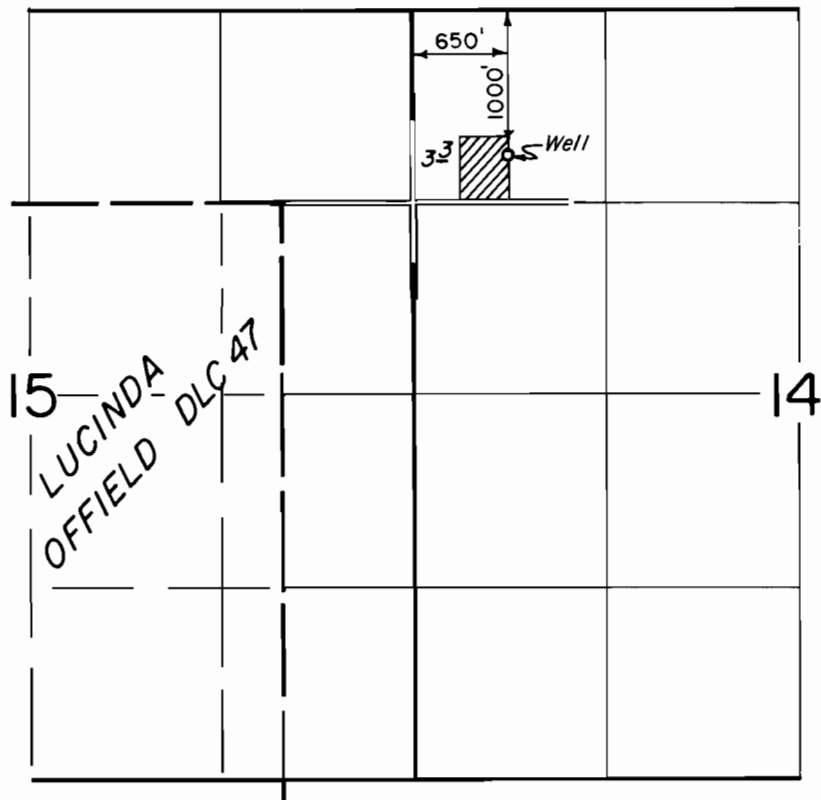

FINAL PROOF SURVEY
UNDER

Application No. G-7267 Permit No. G-6707
IN NAME OF

WILLARD & ROXANNE LIGHTY

Surveyed AUG 14, 1981, by *W. Brown*