


T. 30 S., R. 15 W., W. M.

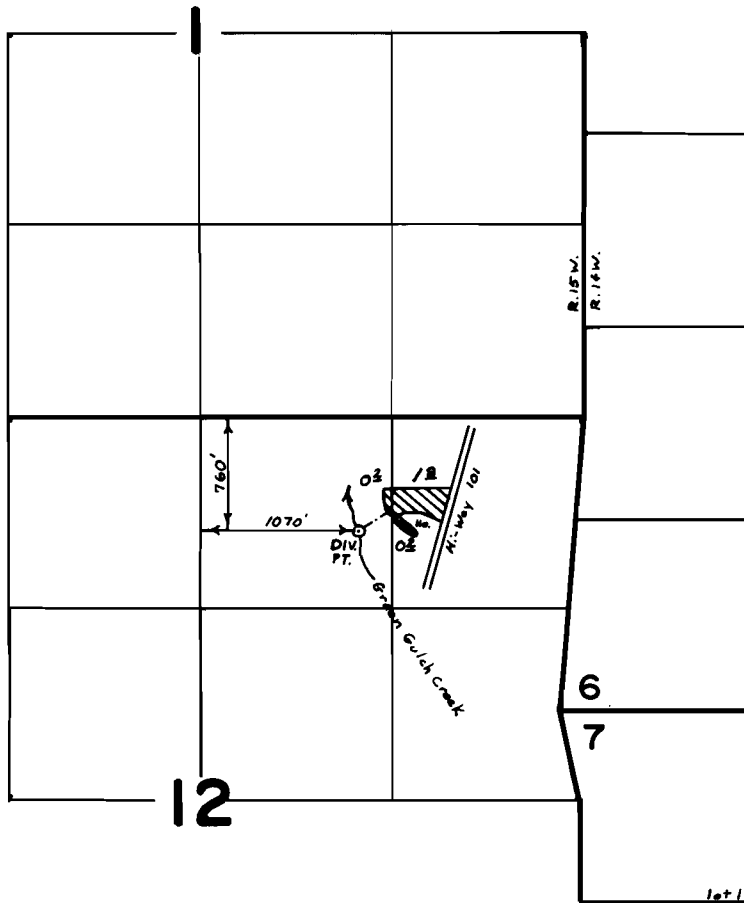

SCALE 4" = 1 mile

FINAL PROOF SURVEY UNDER

Application No. **55619**. Permit No. **41679**.....
IN NAME OF

.....**GALE**.....**E**.....**STEVENSON**.....

Surveyed **June 11, 1979**, by **S. Donaldson**...