


T.31S., R.15W., W.M.

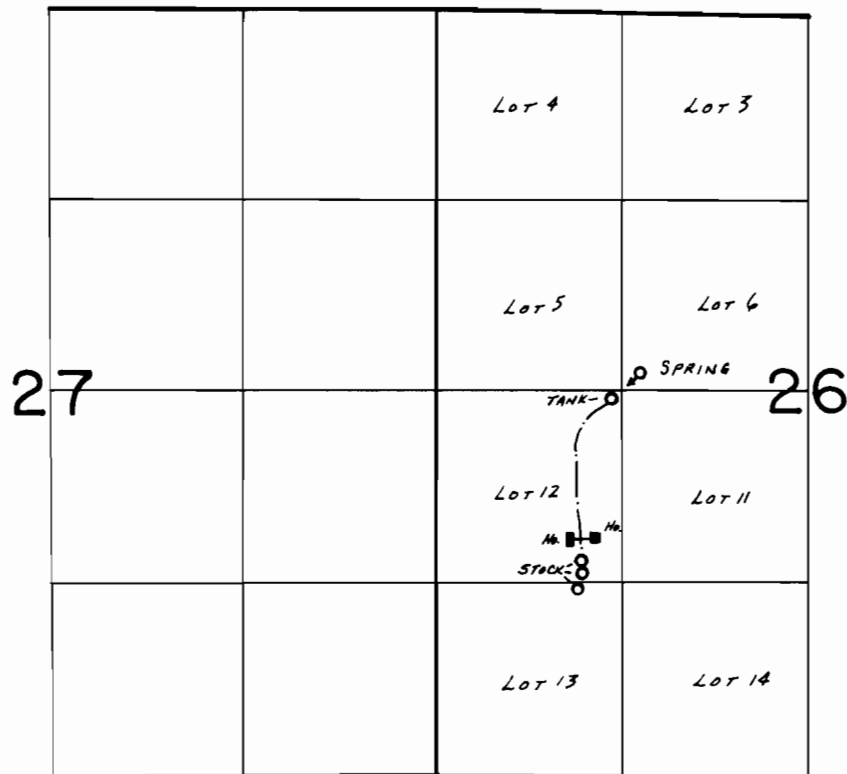

SPRING Loc.: 2790' N. & 1400' E. FROM SW COR. SEC. 26.

FINAL PROOF SURVEY UNDER

Application No. 49997.. Permit No. 37283.....
IN NAME OF

.....STONECYPHER RANCH, INC.

Surveyed JULY 8... 19.80, by J. S. DONALDSON