


T.26S. R.6W. W.M.

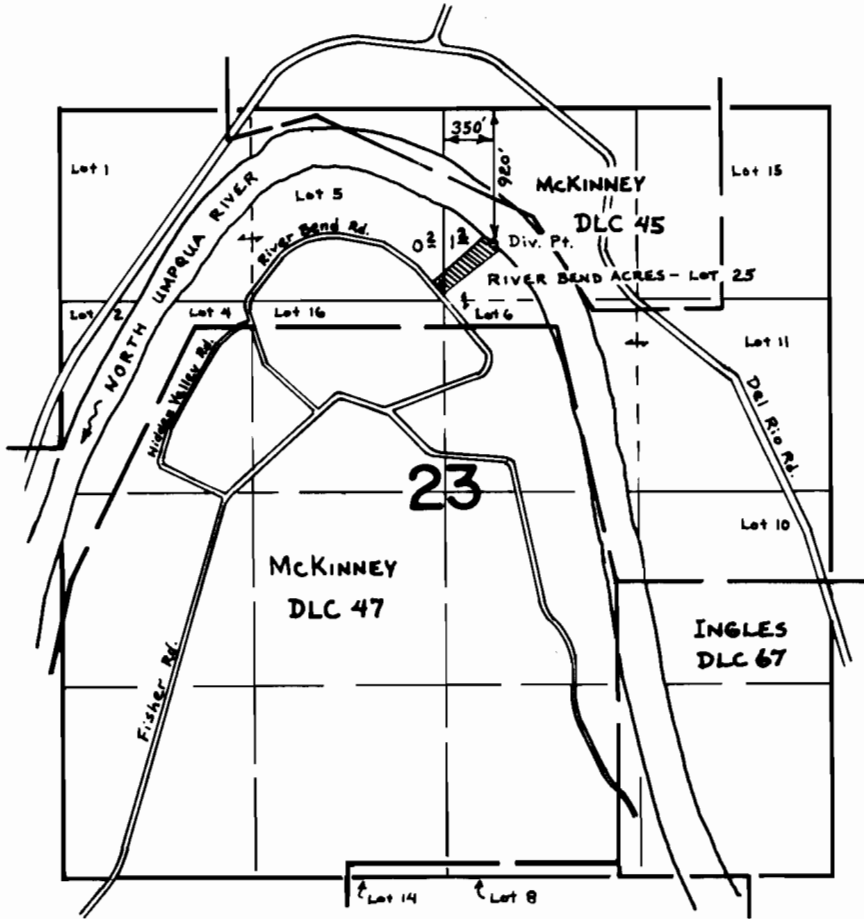

SCALE: 4" = 1 mile

FINAL PROOF SURVEY
UNDER

Application No. 51947 Permit No. 39164
IN NAME OF

.....EDWARD C. & MARIA E. HOY.....

Surveyed May 2, 1979, by S. Donaldson.....