


T.13S.,R.31E.,W.M.

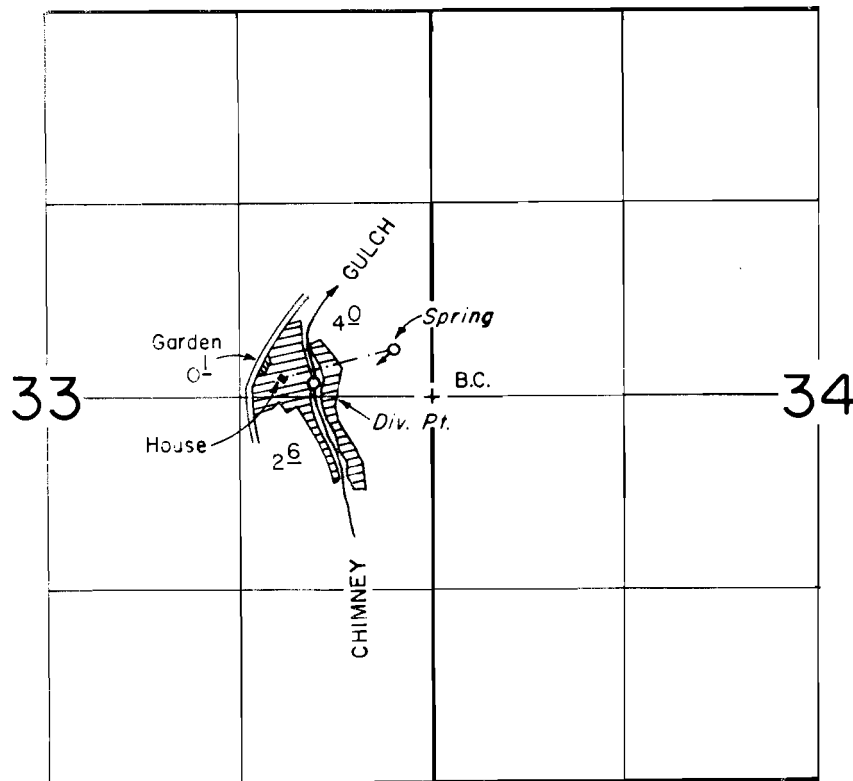

Spring Located: 310' N. & 260' W.; Gulch Diversion Located 100' N. & 800' W.; both from the E 1/4 corner Section 33

FINAL PROOF SURVEY
UNDER

Application No. 55118 41331
55119 Permit No. 41332
IN NAME OF

JOHN & CHARLENE MORRIS

Surveyed JUNE 13, 1980, by *dt. from*