


P-41723  
51243

# T.12S.R.31E.W.M.

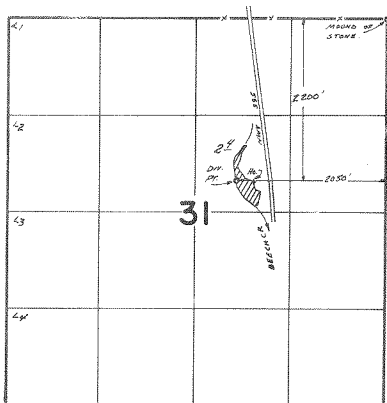

## FINAL PROOF SURVEY UNDER

Application No. 55700... Permit No. 41723.  
IN NAME OF

GLEN R. BROWN

Surveyed June 13 1978, by J.S. Donaldson...  
OCT. 2, 1981, *G.R. Brown*

PTB-1978A *llh*