
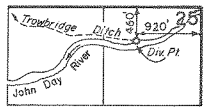
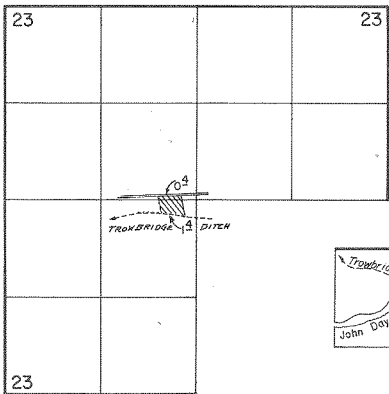


T.13S.,R.31E.,W.M.

 

 PERMIT 43650

FINAL PROOF SURVEY UNDER

Application No. 57988 Permit No. 43650
IN NAME OF

DONALD ILER

Surveyed JUNE 8, 1978, J.S. DONALDSON
JUNE 12, 1980, by *db*

P15-1778 A
P15-1780 A *db*