


Township 10 S

Range 19 E

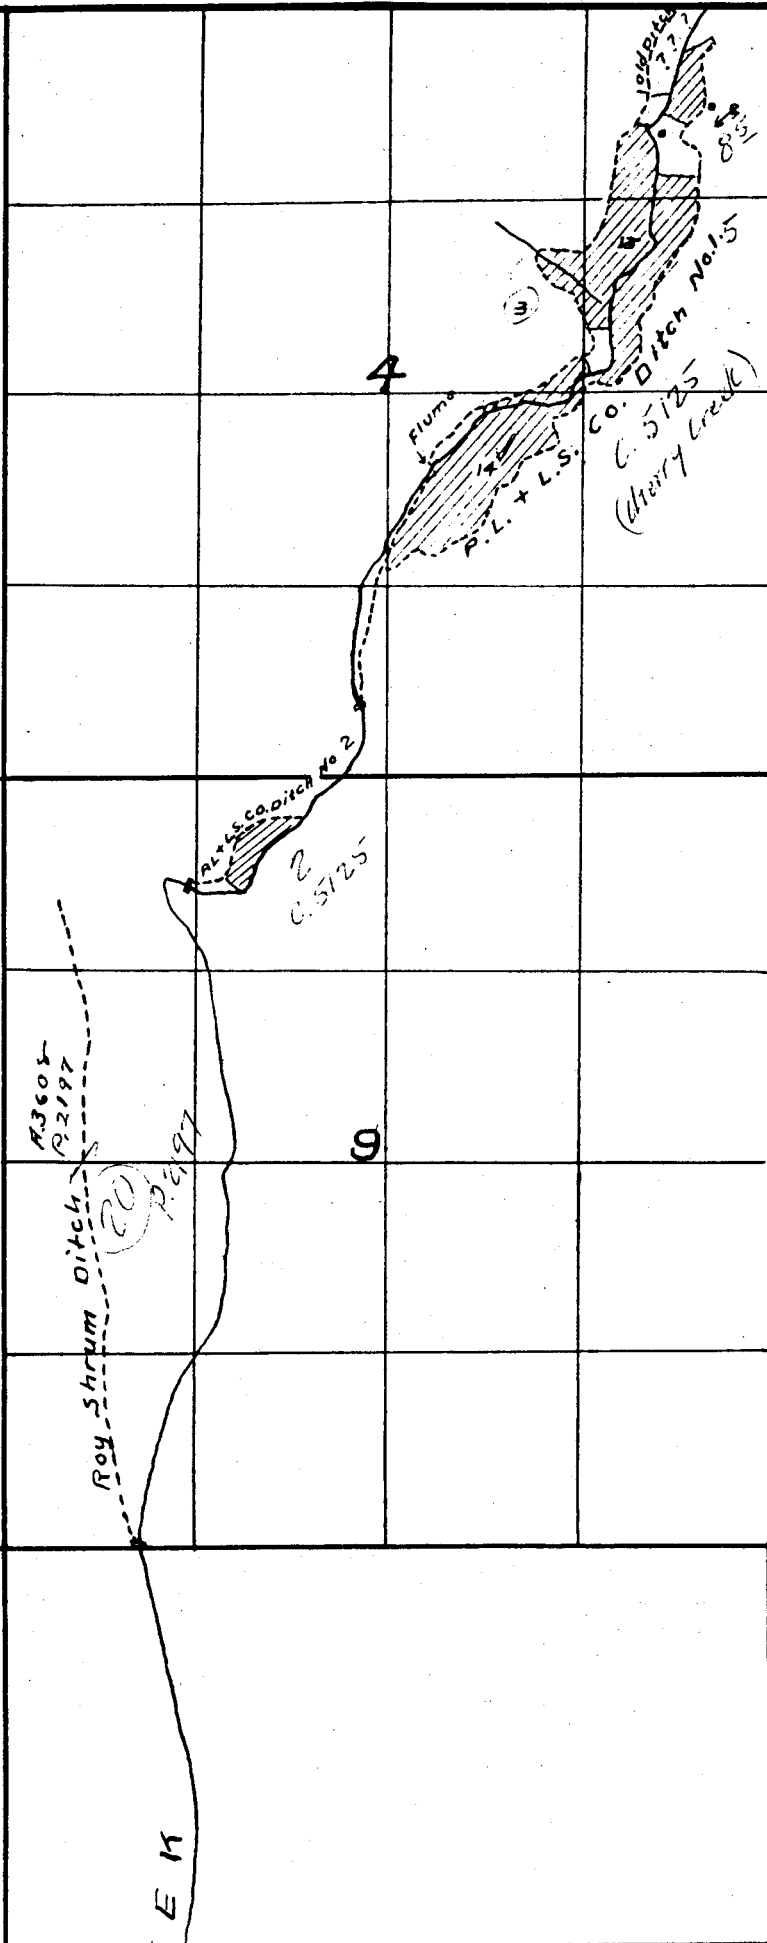

10.6
62
set ditch No. 4
4.5
7215
KOSER DITCH No. 3
2.5
1.5

(20)

C H E R R Y

C R E E K

ROY SHUT

