


T.39S.R.35E.W.M.

Permit G-4156

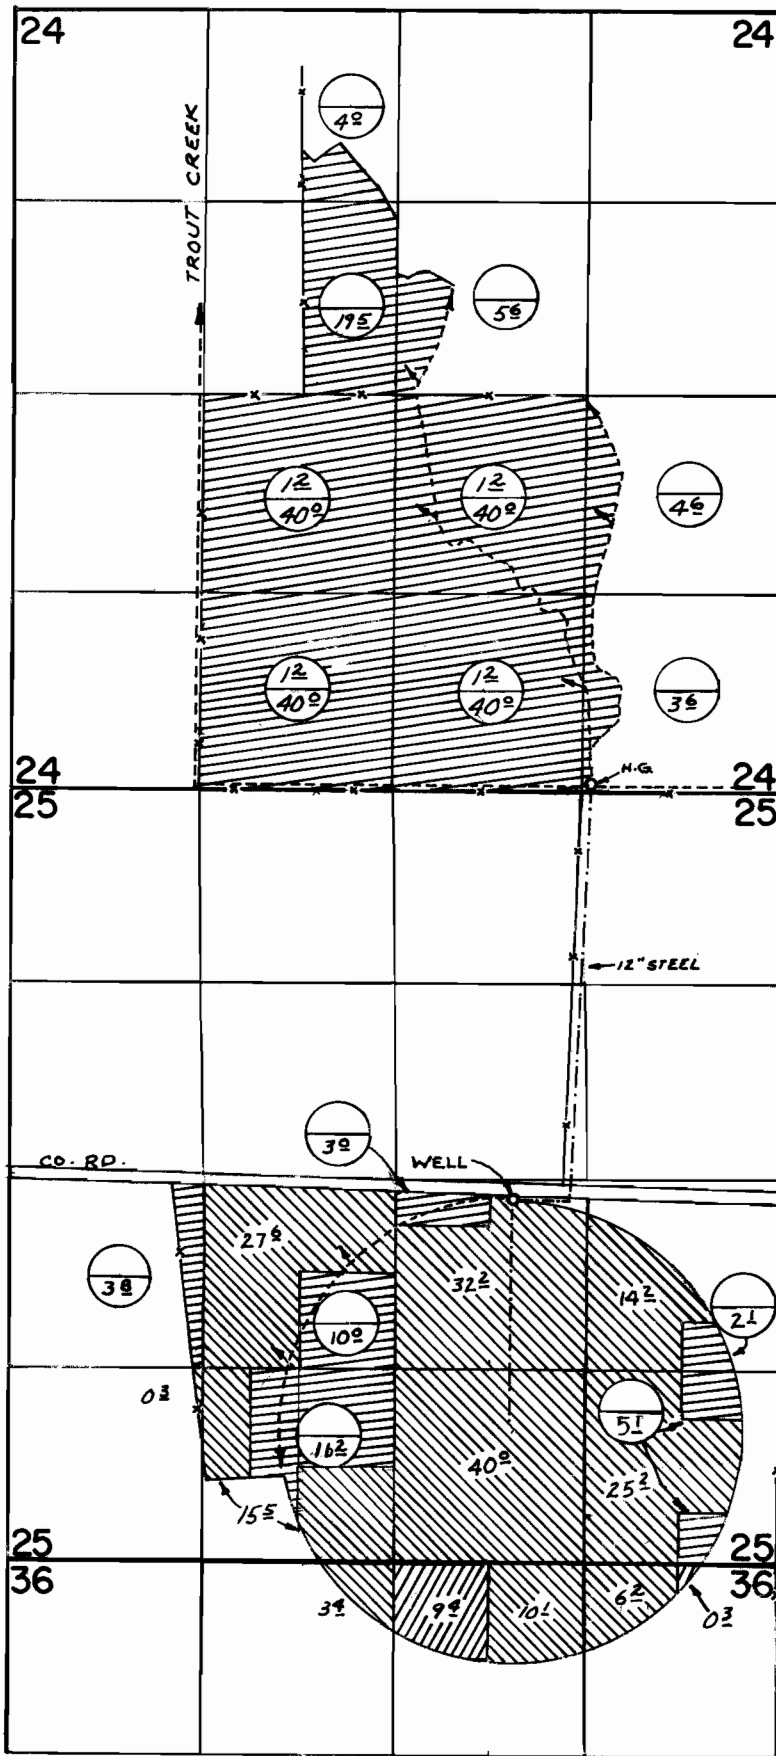

WELL LOC: 2500' N. & 1830' W. FROM S.E. COR. SEC. 25

Permit G-4155

FINAL PROPOSED SURVEY

UNDER

Application No. G-4409 Permit No. G-4155
G-4410 Permit No. G-4156

IN NAME OF

DON S. ORLANDO - TROUT CR. RANCH

Surveyed JUNE 16 1976 by R. MUCKEN