


T.23S.,R.32 1/2E.,W.M.

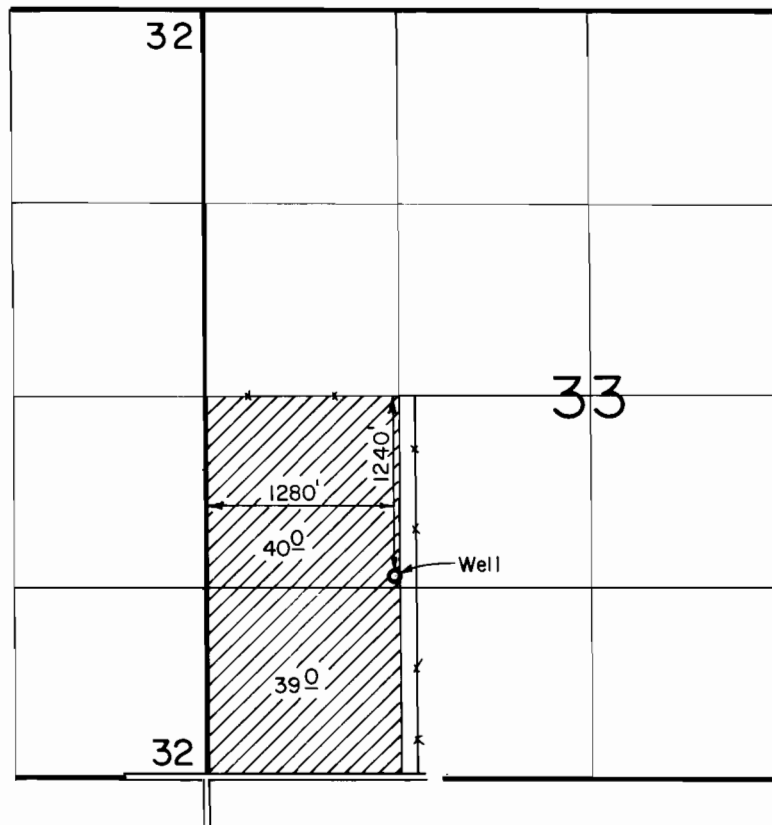

**FINAL PROOF SURVEY**  
UNDER

Application No. G-9141 Permit No. G-8596..  
IN NAME OF

**RICHARD S. BAKER**

Surveyed JULY 10, 1980, by *McB...*