


T. 2 N., R. 10 E., W. M.

SEC. 21

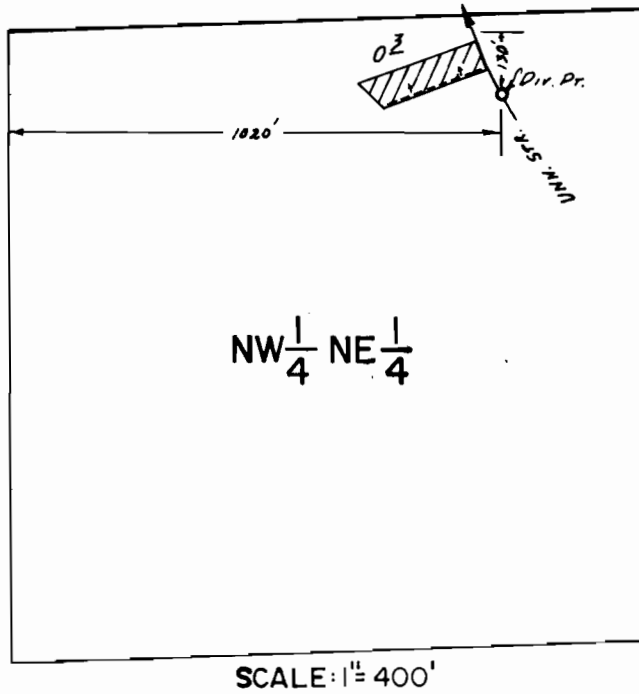

FINAL PROOF SURVEY
UNDER

Application No. 50892... Permit No. 38425...
IN NAME OF

RONALD R. & LORNA L. GREENWOOD

Surveyed APR. 23... 19.80, by R. G. MUCKEN...