
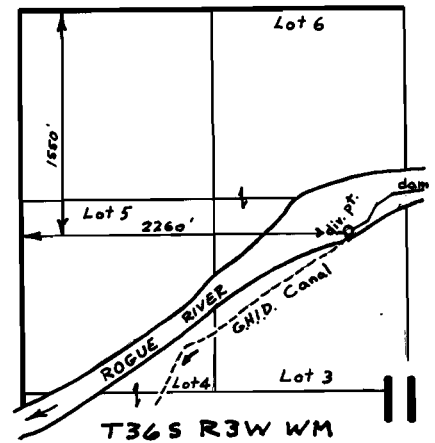


+ T. 36 S., R. 4 W., W. M.

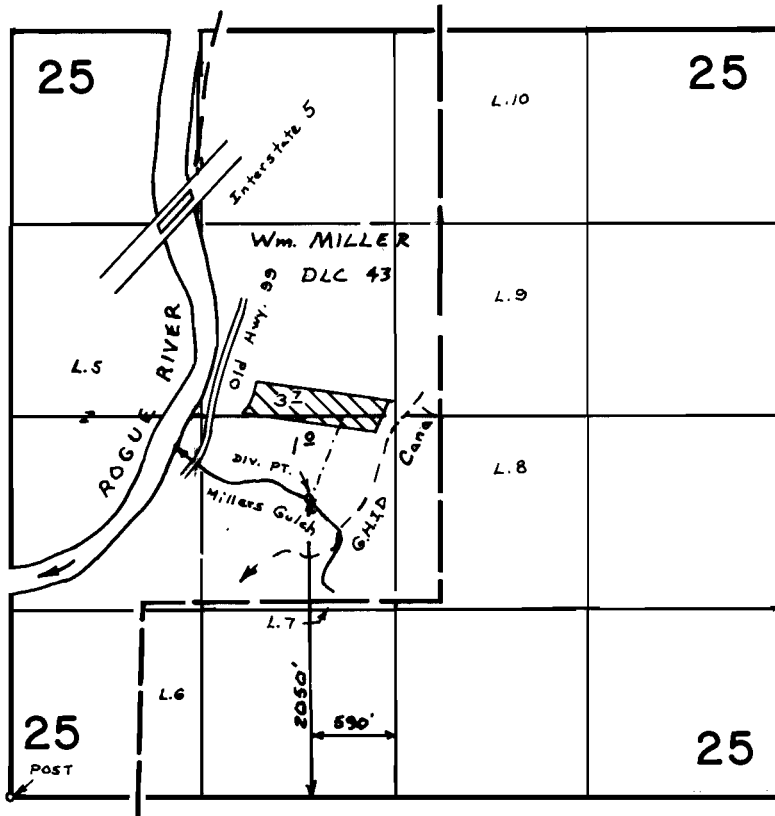

FINAL PROOF SURVEY
UNDER

Application No. 47972 Permit No. 35984
IN NAME OF

Raymond F. Viola Lick

Surveyed FEB. 22 1978, by B. SUND

D.H.M.
B50-10-5