


T. 40 S., R. 4 W., W.M.

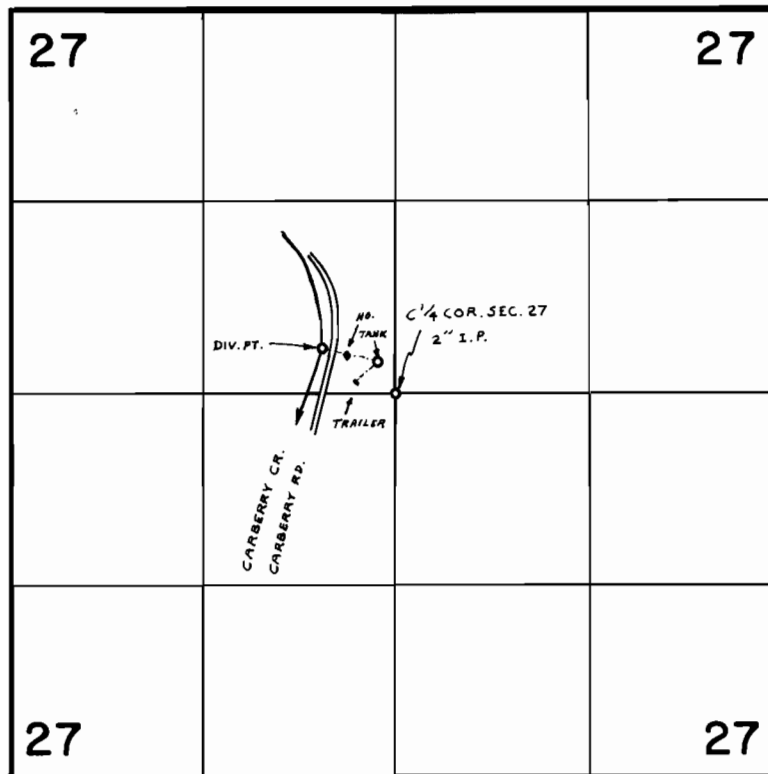

DIV. PT. LOC. : 320' N. & 310' W. FROM C 1/4 COR. SEC. 27

FINAL PROOF SURVEY
UNDER

Application No. 54125 Permit No. 40517
IN NAME OF

VIRGIL E. &/OR LORA SHAW

Surveyed JUN. 19 1978 by B. SUND