


T. 36 S., R. 3 W., W.M.

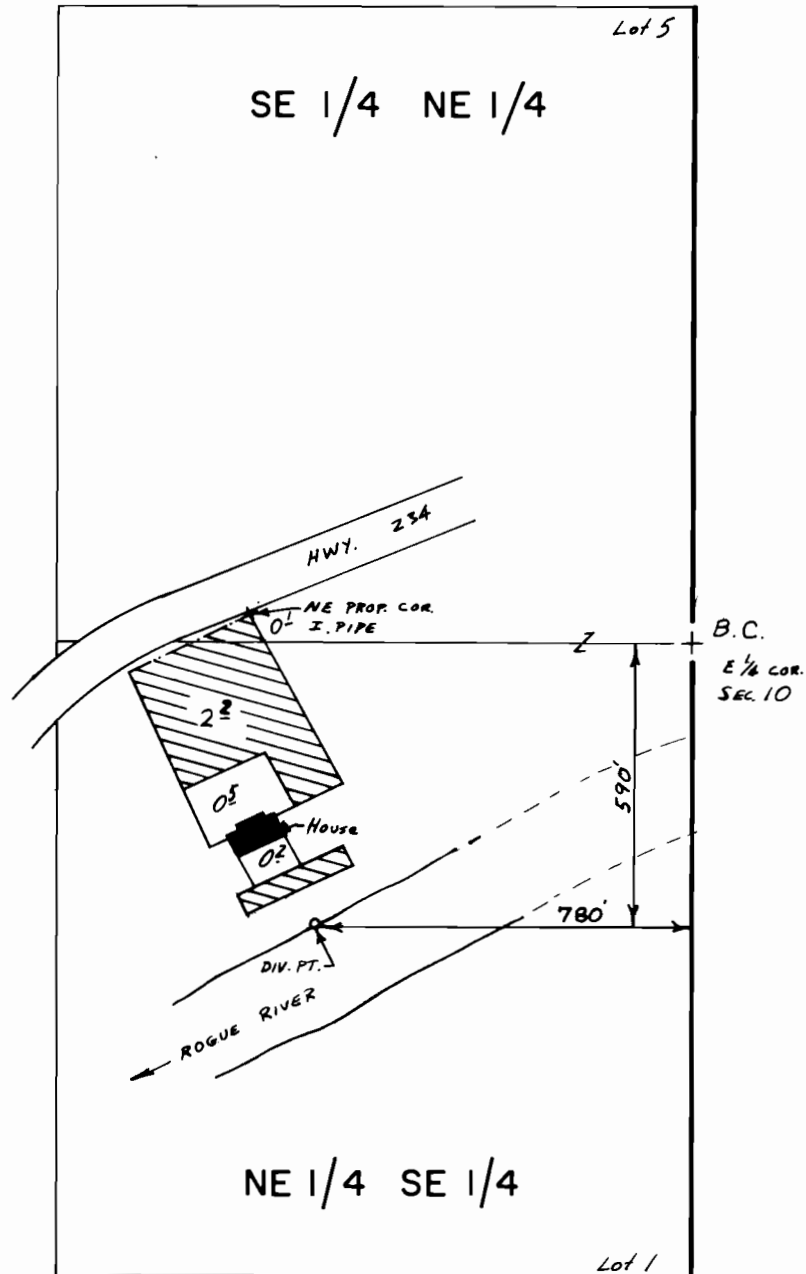

Scale: 1"=400'

FINAL PROOF SURVEY
UNDER

Application No. 55157..... Permit No. 41399.....
IN NAME OF

.....GRANT.....A.....APPLETON.....

Surveyed SEPT. 21., 1978., by BRUCE R. SUND.