


T. 34 S., R. 1 W., W.M.

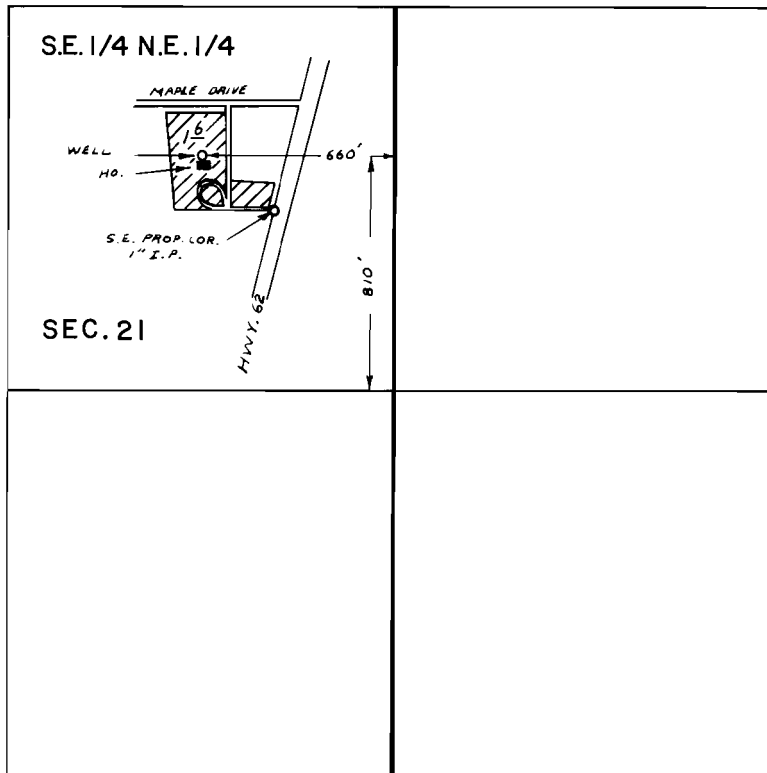

SCALE : 1" = 660 FT.

**FINAL PROOF SURVEY**  
UNDER

Application No. G-7627      PermittNo. G-7093  
IN NAME OF

JOSEPH A. BOWDOIN

Surveyed AUG. 16 1978, by B. SUND