


T. 38 S., R. 2 W., W.M.,

Sec. 32

SE 1/4 SE 1/4

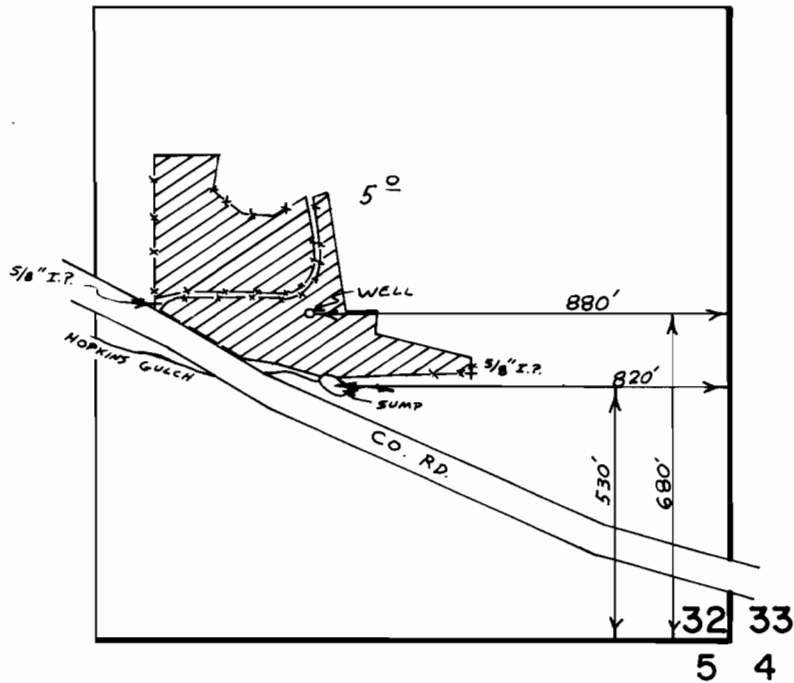

Scale : 1" = 400'

FINAL PROOF SURVEY
UNDER

Application No. G-7647 Permit No. G-7216
IN NAME OF

GARY WILLIAM DEGARMO

Surveyed MAY 5, 1982, by B.R. SUND