


T.36 S., R.7 W., W.M.

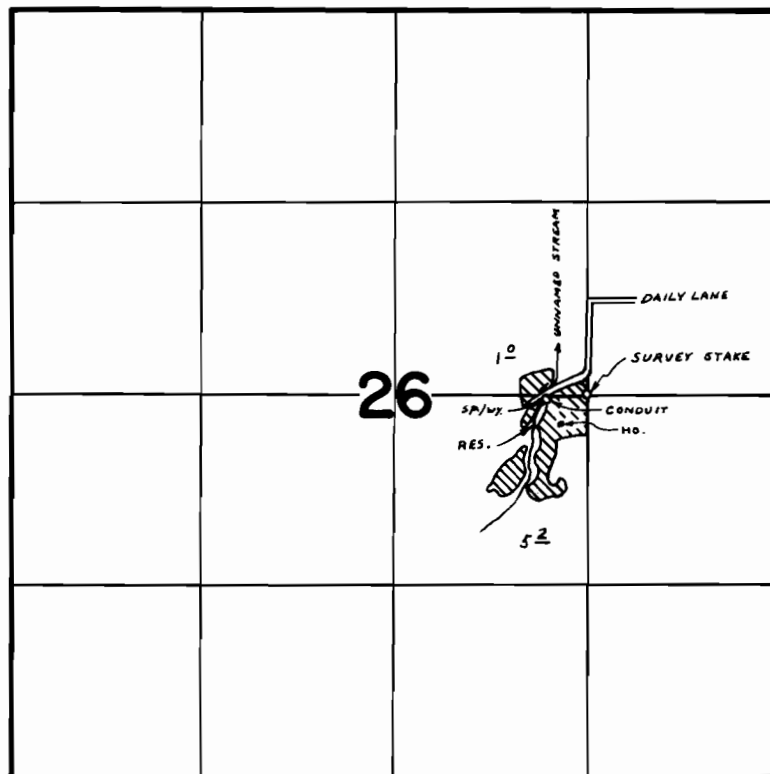

DAM LOC.: 20' S. & 1040' E. FROM CEN. 1/4 COR. SEC. 26

**FINAL PROOF SURVEY
UNDER**

Application No. 48322 R-48321 R-5875
Permit No. 36285
IN NAME OF
GORDON E. WHEELER

Surveyed OCT. 10 1978 by B. SUND