


T. 39 S., R. 5 W., W.M.

Sec. 10

SW 1/4 NE 1/4

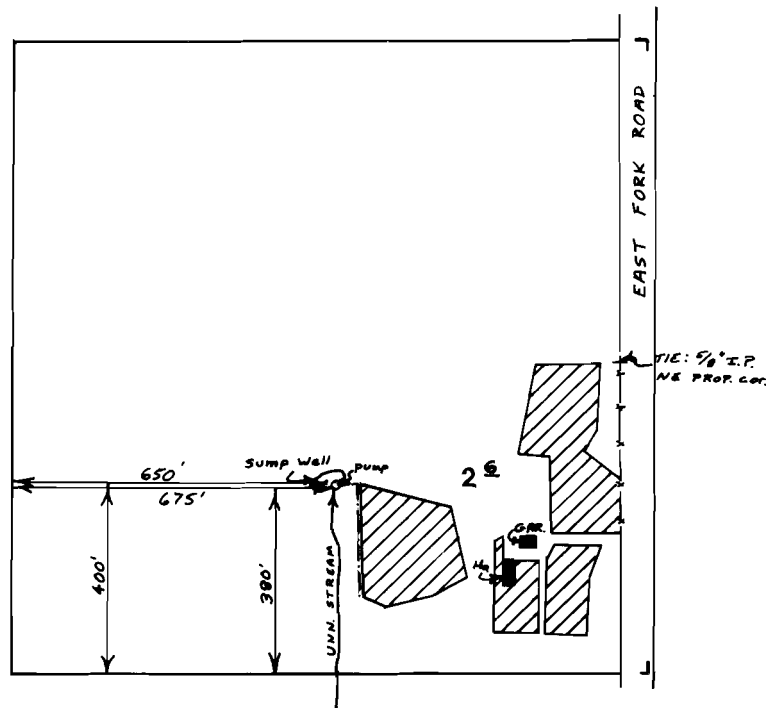

PRIMARY ☒ SUMP WELL
SUPP'L ☒ UNN. STREAM

FINAL PROOF SURVEY
UNDER

G-5337

G-5481

Application No. 54315... Permit No. 40725....

IN NAME OF

WIGHT F. & VIRGINIA ATKINS...

Surveyed Oct...1,.... 19.80, by BR. SUND.....

Scale: 1" = 400'