


G 8738
T 8487
51273

T.25S.,R.19E.,W.M.

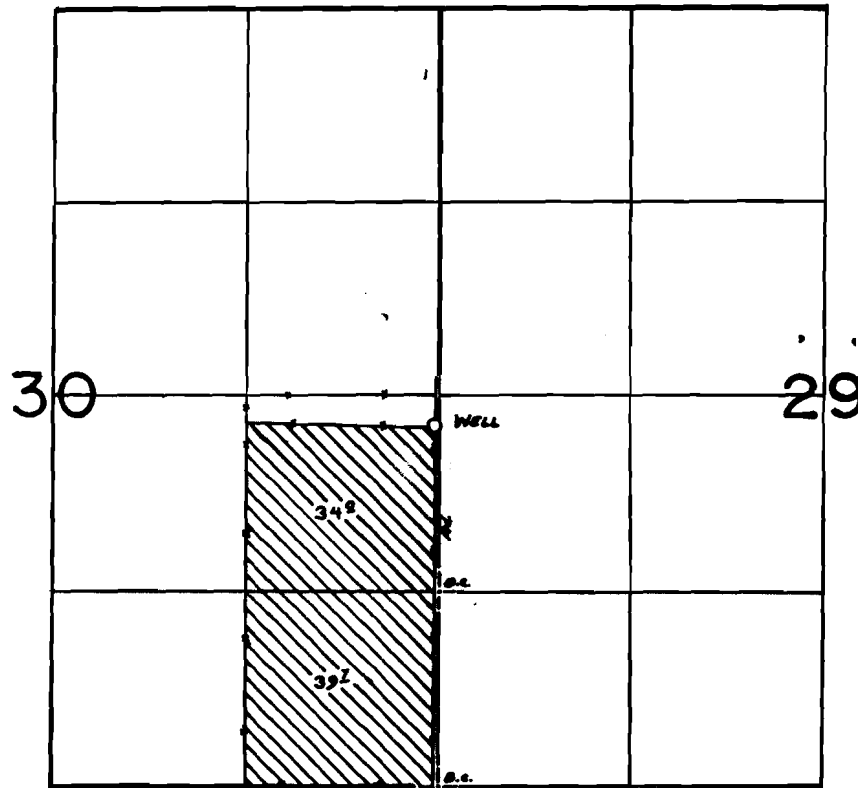

Well Loc: 2460 ft. N. and 40 ft. W. from the SE Cor. Sec.30

FINAL PROOF SURVEY
UNDER

Application No. G-9375 Permit No. G-8738
IN NAME OF

.....*Brent Lanier*.....

Surveyed OCT 28 1981, by L. TOLL