


G 8777
T8487
51274

T.25S.,R.19E.,W.M.

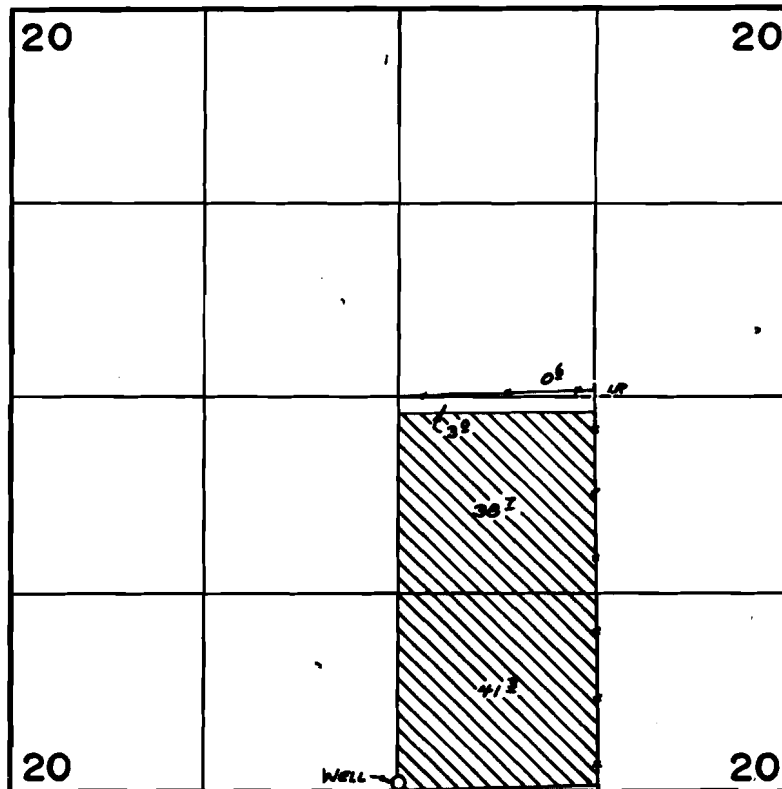

Well Loc: 60 ft. N and 20 ft. E from the S 1/4 Cor. Sec. 20

FINAL PROOF SURVEY UNDER

Application No. G-9403 Permit No. G-8777
IN NAME OF

.....Brant Lanier.....

Surveyed OCT. 28, 1981, by L. TOLL.....