


T.19S.,R.4W.,W.M.

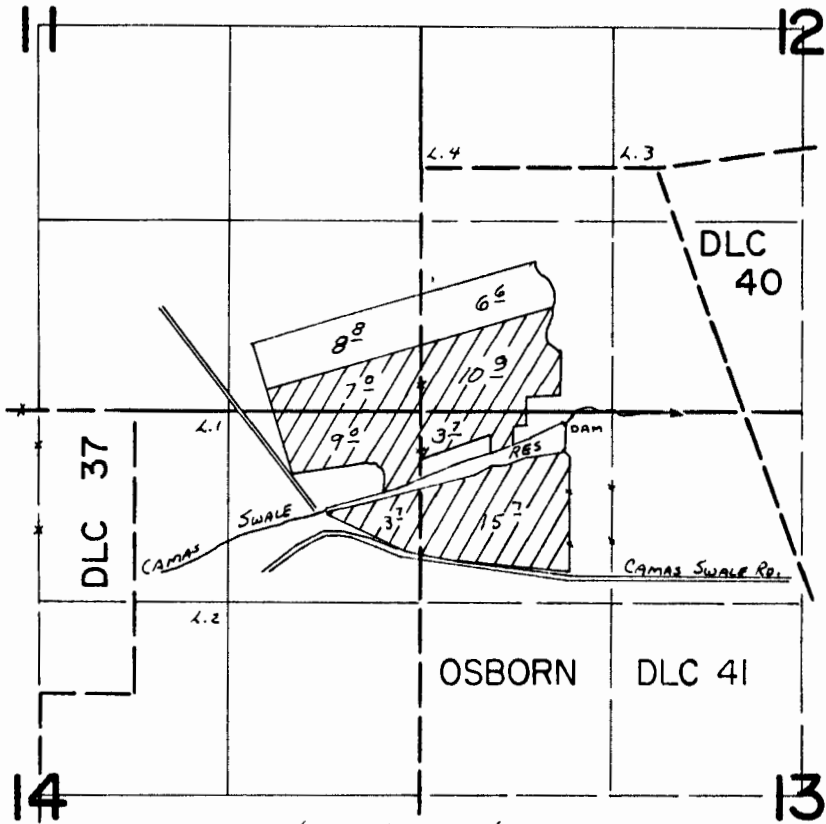

Div. Pl. Loc.: 80 ft. S., & 1000 ft. E. from NW c. Sec 13

FINAL PROOF SURVEY

UNDER

Application No. R-45398 Permit No. R-5337
45207 33772
 IN NAME OF

KENT & BRYCE OLSON

Surveyed APRIL 15, 1975, by L. Tall
MAY 9, 1980 S. Brown