


T.19S.,R.4W.,W.M.

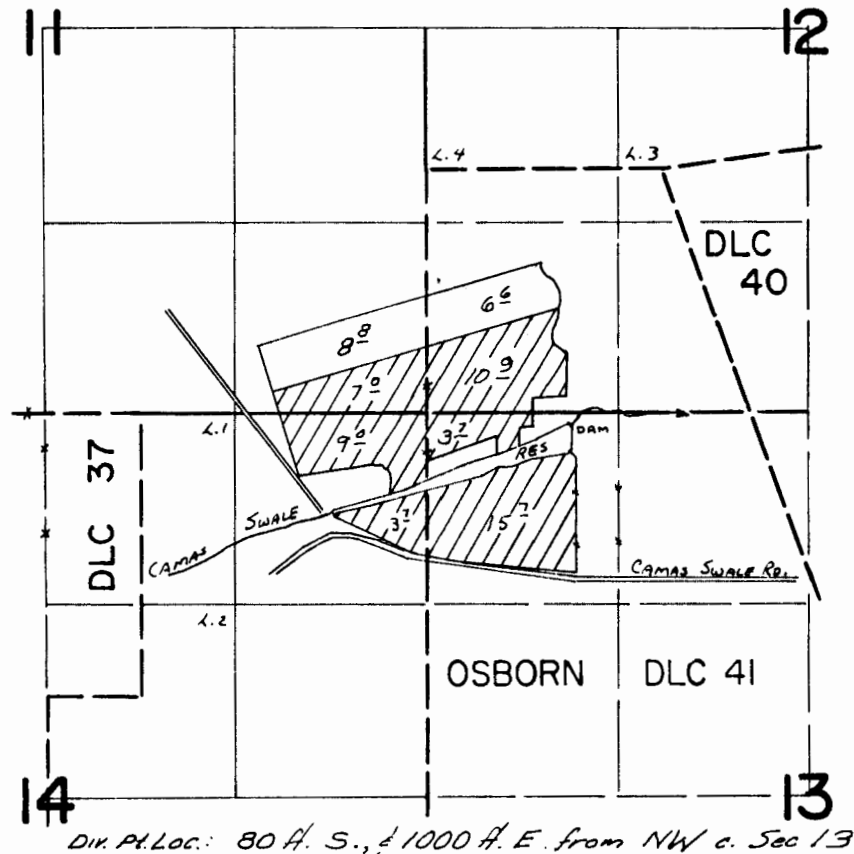

Dir. Pt. Loc.: 80 ft. S., & 1000 ft. E. from NW c. Sec 13

FINAL PROOF SURVEY UNDER

Application No. R-45398 45207 Permit No. R-5337 33772
IN NAME OF

KENT & BRYCE OLSON

Surveyed APRIL 15, 1975, by L. T. R. 11
MAY 9, 1980 S. Brown