


T.13S., R.1E., W.M.

SECTION 2

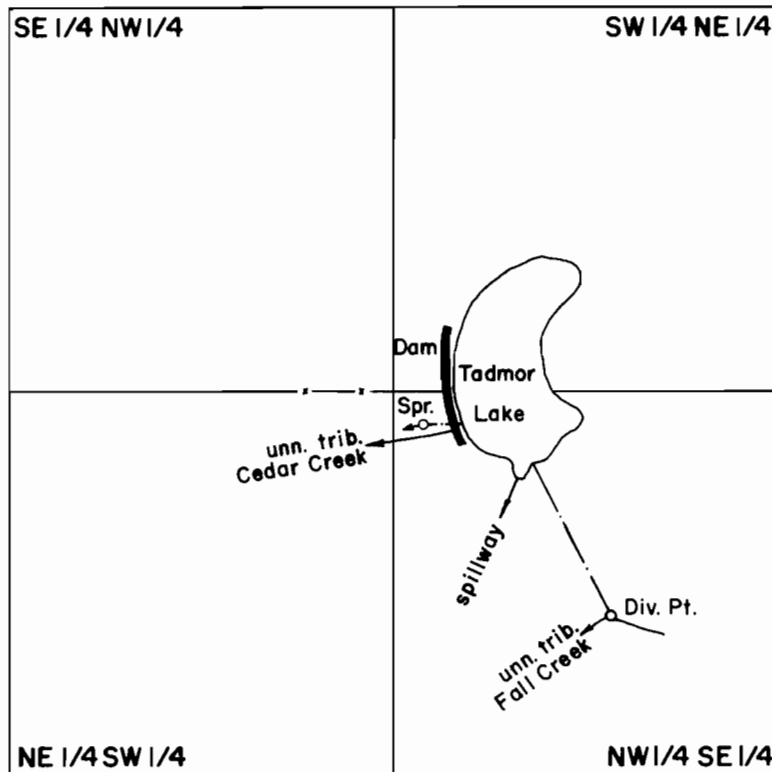

DIV. PTS. LOC: Cedar Cr. trib.-140' S & 210' E; Fall Cr. trib.-760' S & 750' E; Spr.-110' S & 100' E all from center section 2

FINAL PROOF SURVEY UNDER

R-49749
49750

R-5841
36085

Application No. 51129 Permit No. 37543
IN NAME OF

CONSERVATIVE BAPTIST ASSOCIATION OF OREGON

Surveyed July 9 1976, by D. Norby