


T.6S. R.1&2W., W.M.

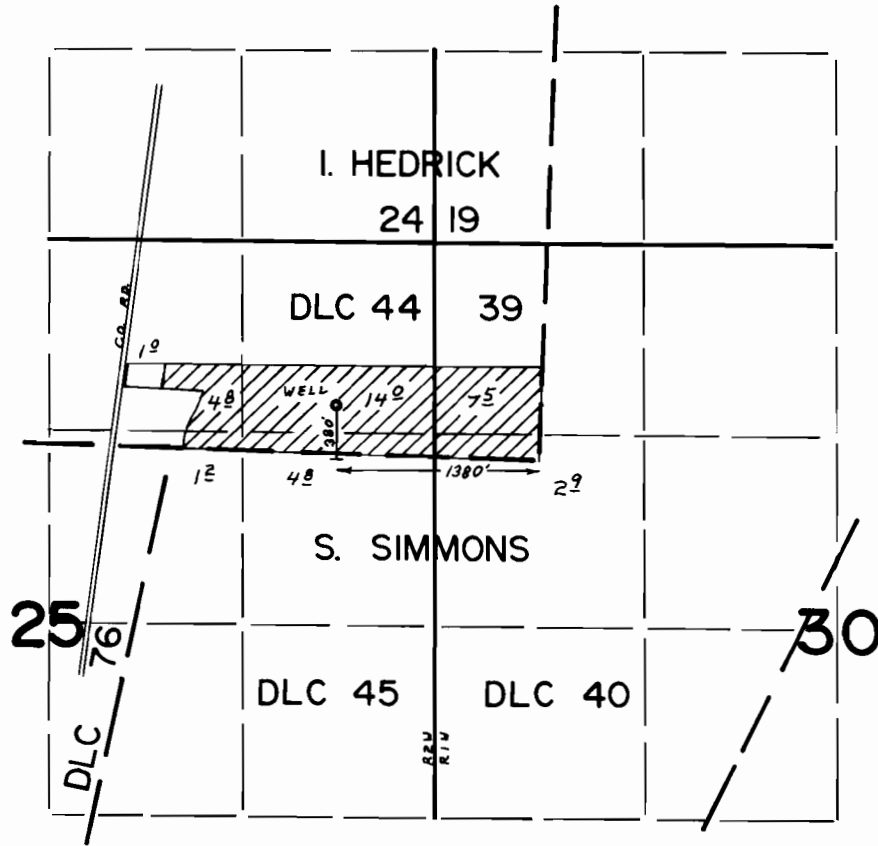

FINAL PROOF SURVEY UNDER

Application No. G-6975. Permit No. G-6483.....
IN NAME OF

.....CARL DITCHEN.....

Surveyed APR. 26. 1979., by L. H. NUNN.....