


# T.8S.,R.6W.,W.M.

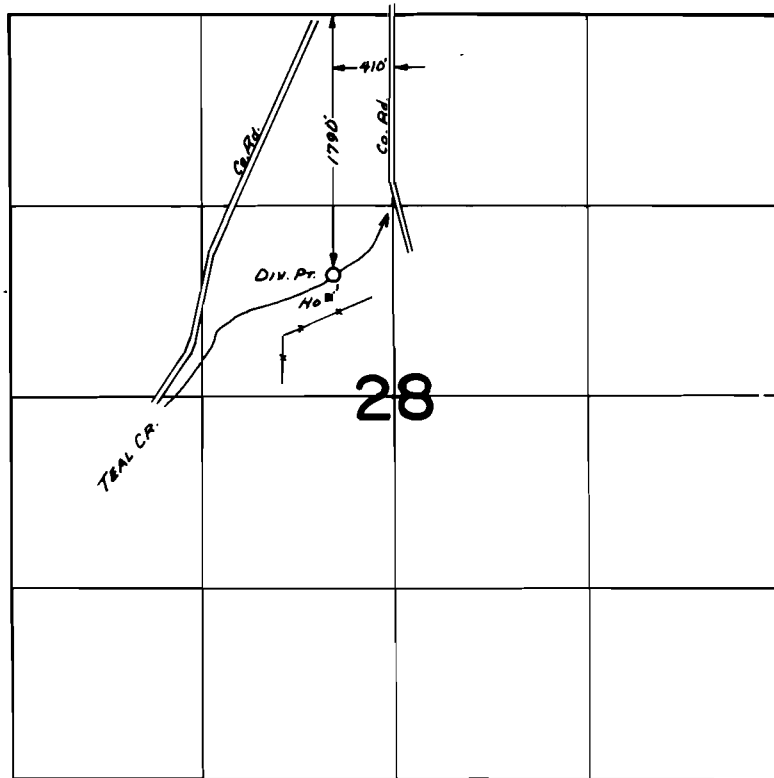

## FINAL PROOF SURVEY UNDER

Application No. 55777. Permit No. 41765.....  
IN NAME OF

.....RICHARD BUNSE.....

Surveyed Sept...9... 1981., by ...L...TOLL.....