


G-5812

76263
51295

T. 3N. R. 28E. W. M.

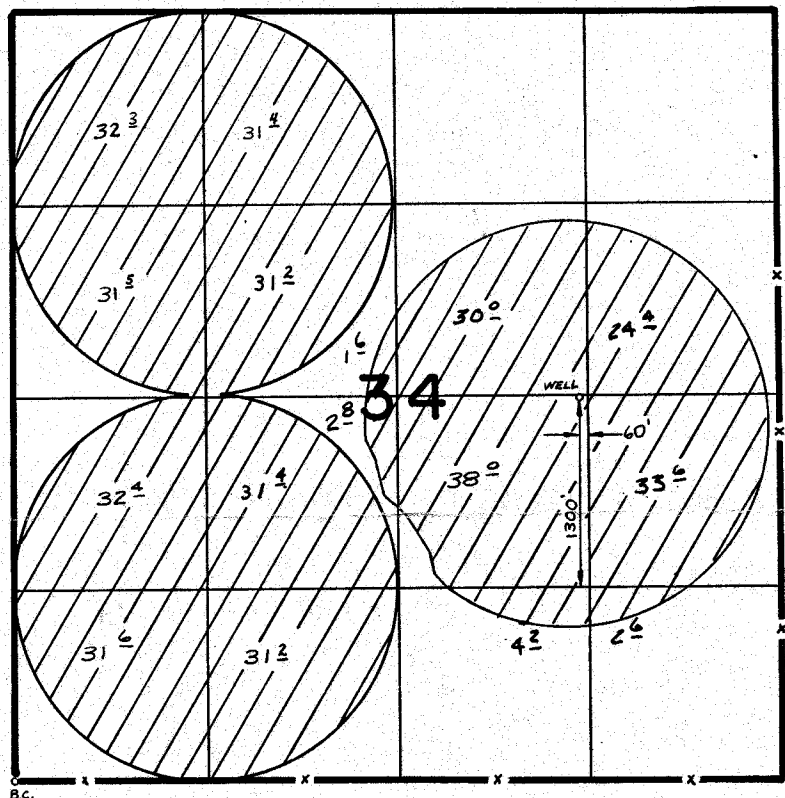

FINAL PROOF SURVEY UNDER

RECEIVED

JUN 21 1982

WATER RESOURCES DEPT
SALEM, OREGON

Application No. G-5820 Permit No. G-5812.
IN NAME OF

.....*David Sparks*.....

Surveyed *1-30* 19*79*, by *R. BARWIN*.....