


G-440
G-1549

T.182N.R.13E.W.M.

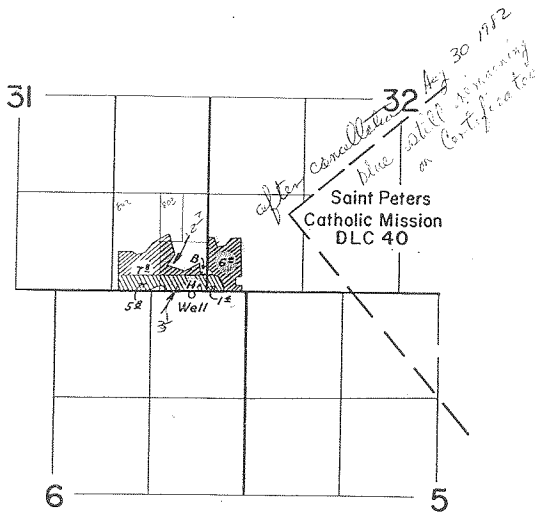

FINAL PROOF SURVEY
UNDER

Application No. *G-1689* Permit No. *G-292*
IN NAME OF

Arthur R. & Mary M. Anderson

Surveyed *April 10 1962*, by *Thomas R. Lauer*