


PF 27758


T.2S. R.12E. WM. RECEIVED

SEP 1 1982

WATER RESOURCES DEPT.  
SALEM, OREGON

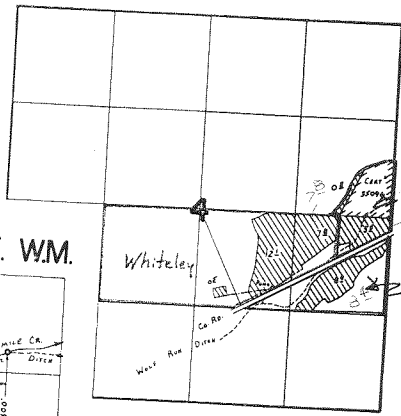

T.2S. R.11E. WM.

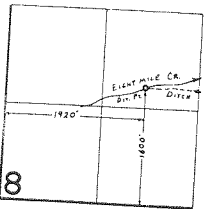

78

FINAL PROOF SURVEY  
UNDER

Application No. 50777. Permit No. 37758.....  
 IN NAME OF  
 RICHARD C. CANTRELL  
 SUNE CARL & ETHEL JOHNSON  
 GEORGE H. & VIRGINIA C WHITELEY  
 Surveyed June 27 1979 by C.L. HUGHES.....